



DATE	
BY	
REVISIONS	
NO.	
DATE	
BY	
REVISIONS	
NO.	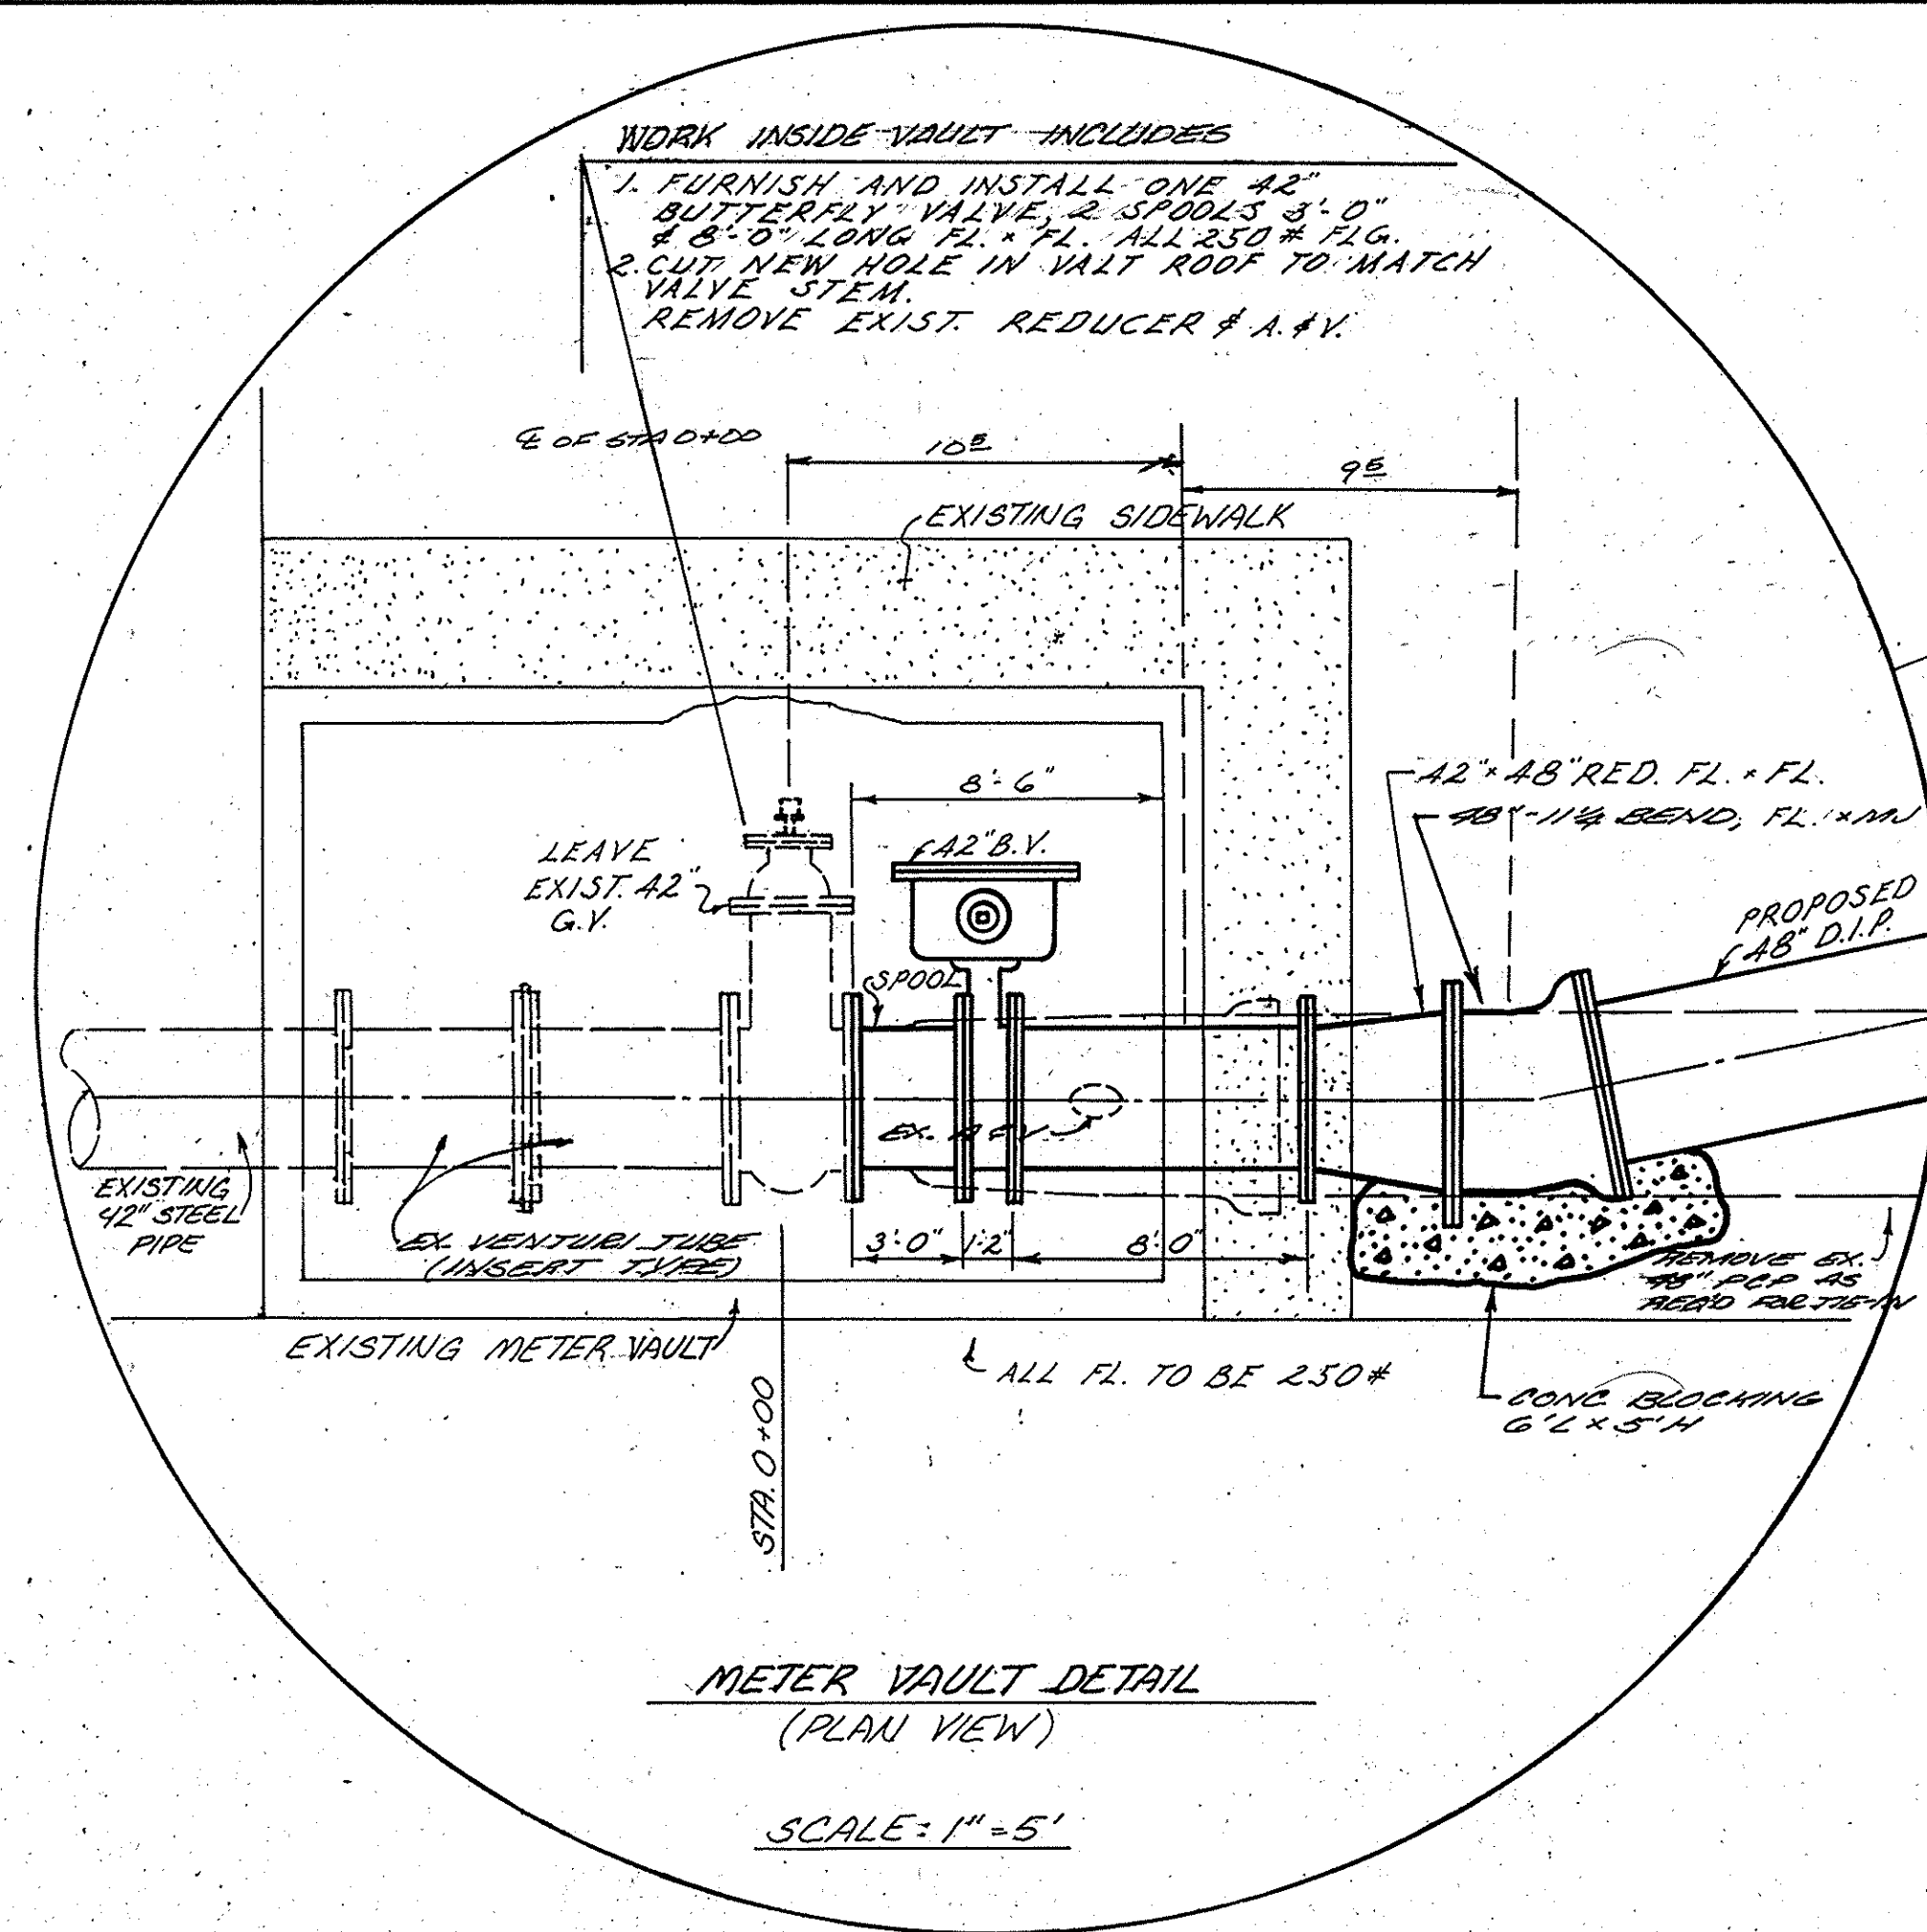
METER VAULT DETAIL
(PLAN VIEW)
SCALE: 1" = 5'

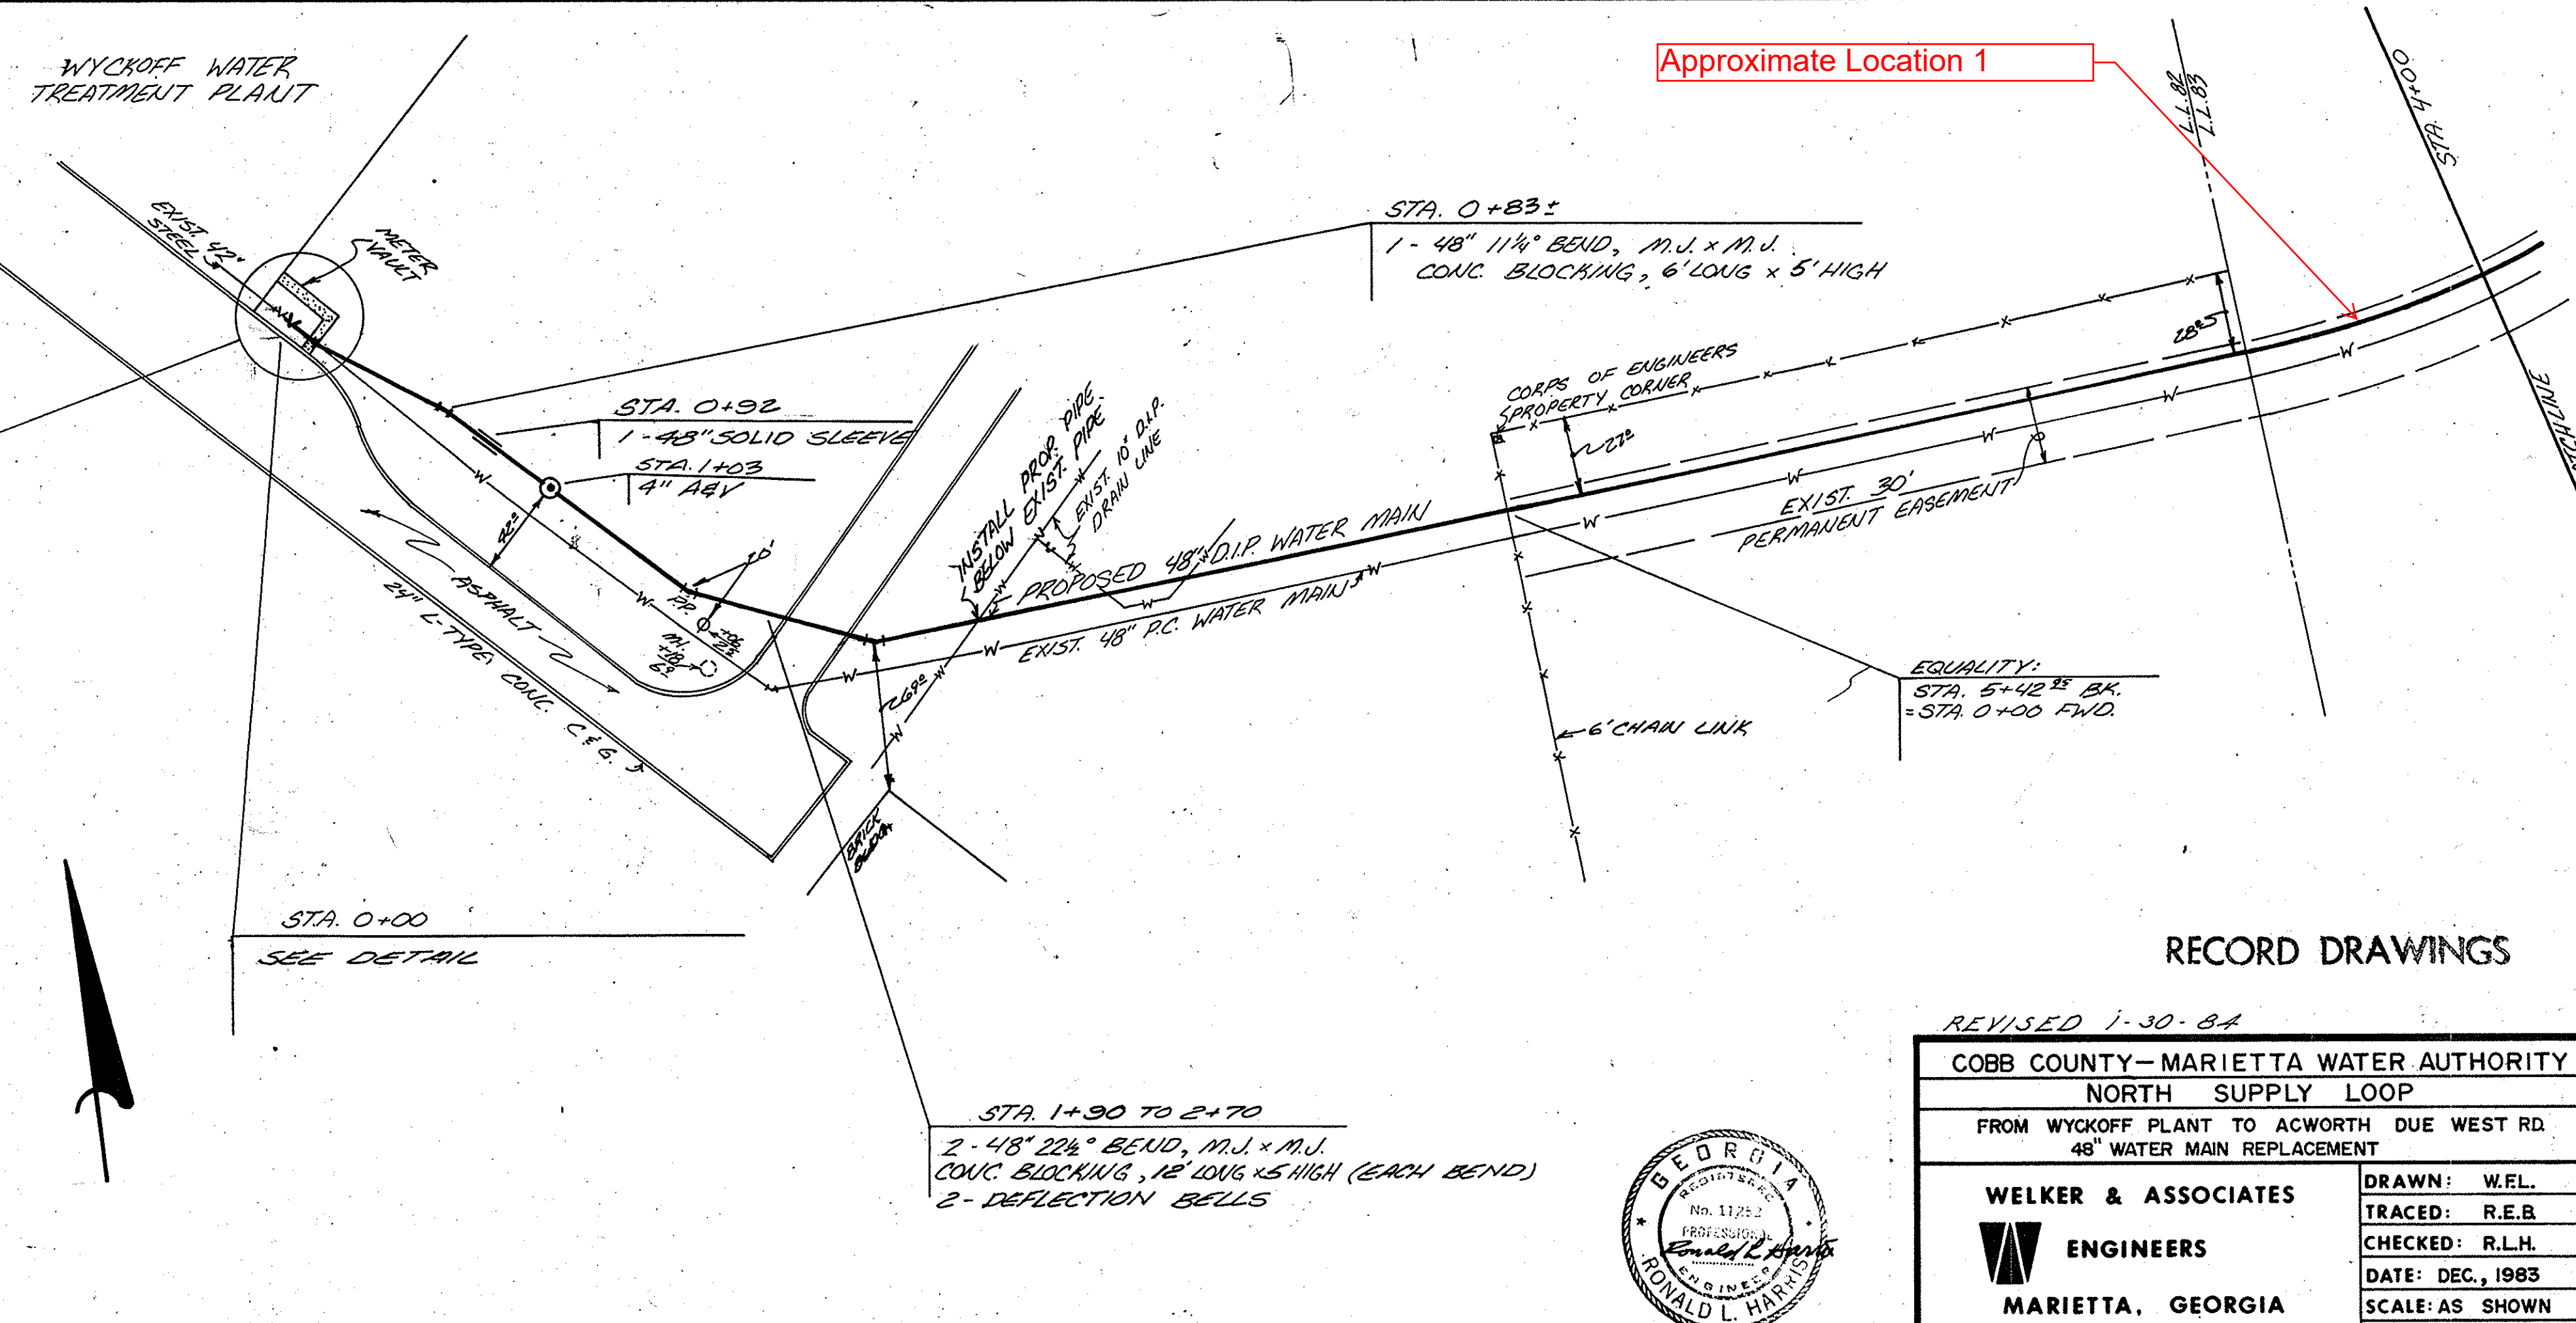

PLAN PROFILE
SCALE: 1" = 50'
VERT: 1" = 10'

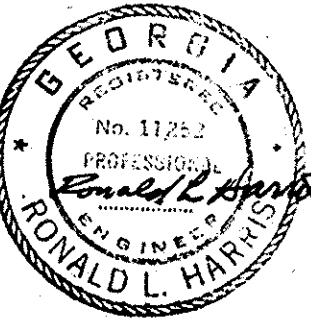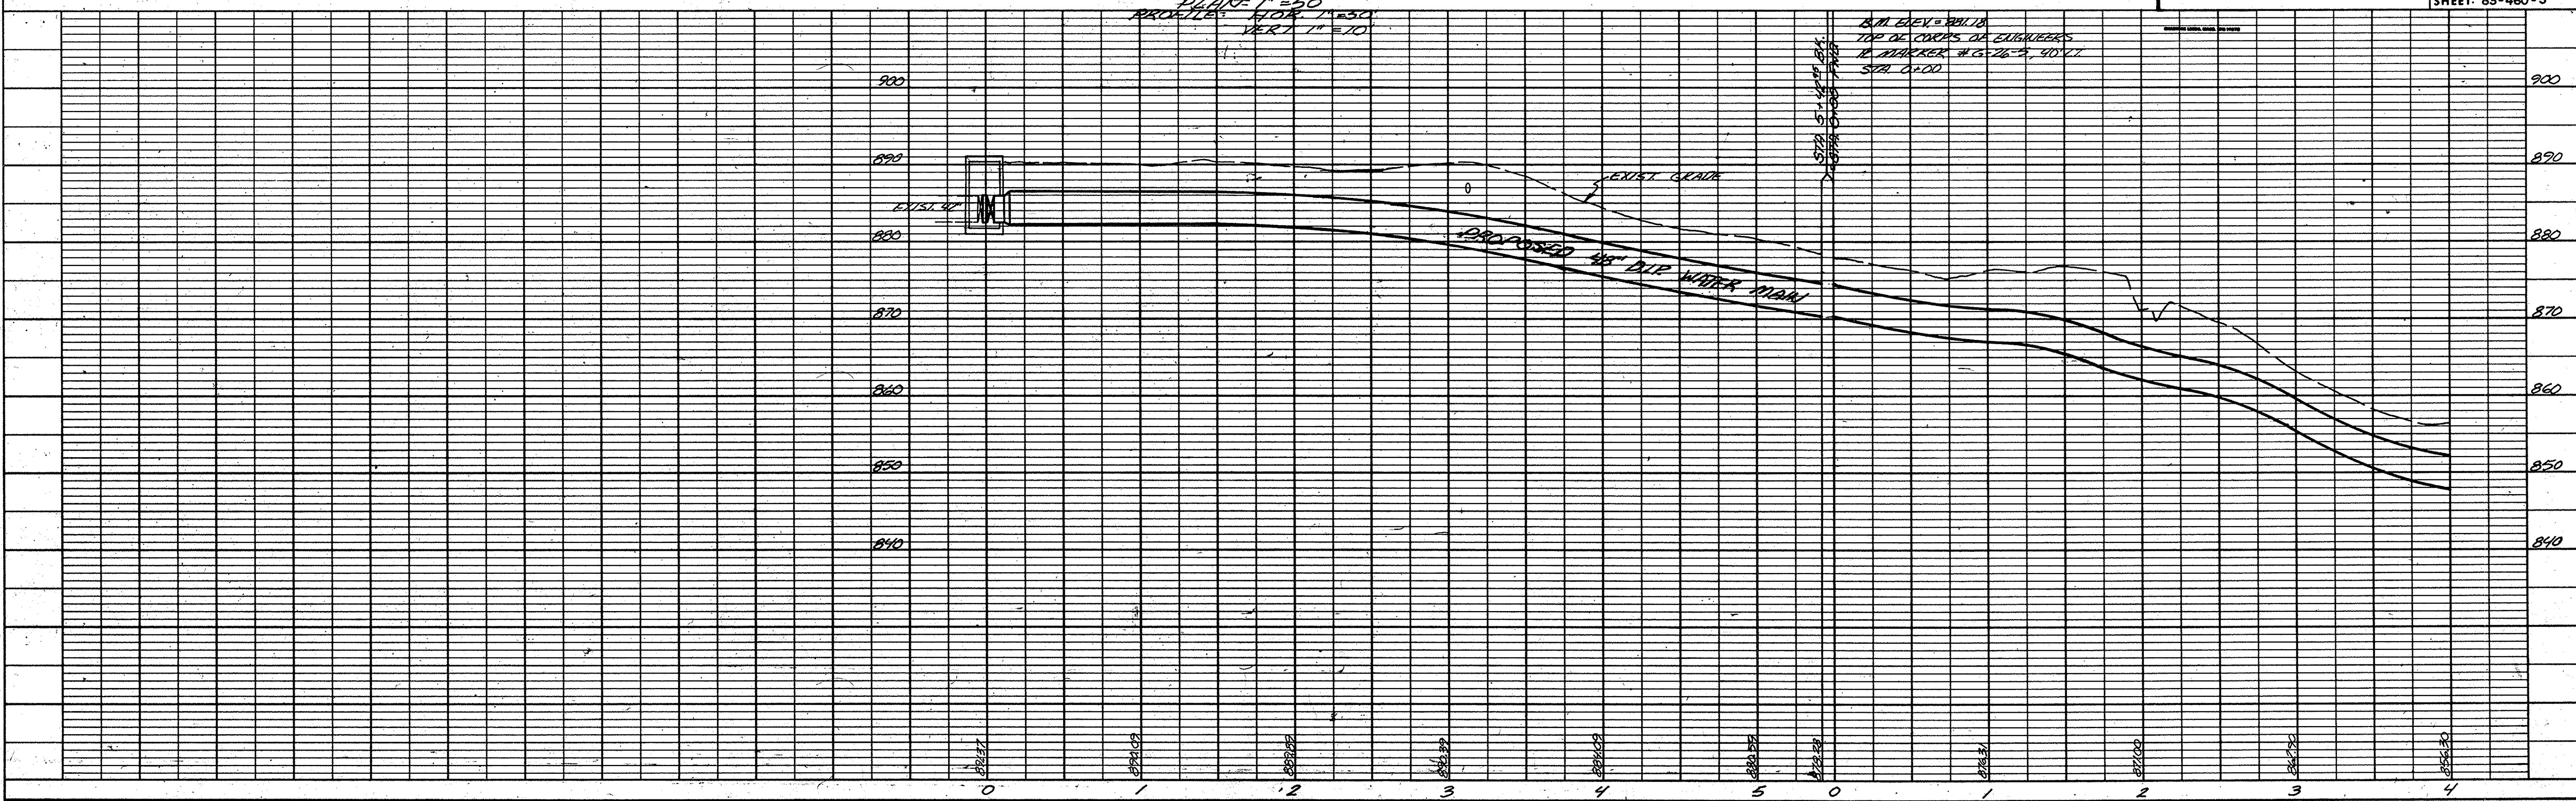

RECORD DRAWINGS

REVISED 1-30-84



COBB COUNTY - MARIETTA WATER AUTHORITY
NORTH SUPPLY LOOP
FROM WYCKOFF PLANT TO ACWORTH DUE WEST RD
48" WATER MAIN REPLACEMENT

WELKER & ASSOCIATES
ENGINEERS
MARIETTA, GEORGIA

DRAWN: W.E.L.
TRACED: R.E.B.
CHECKED: R.L.H.
DATE: DEC, 1983
SCALE: AS SHOWN
SHEET: 83-460-3

DATE	
BY	
SURVEYED	
PLOTTED	
NOTE BOOK	
NO.	

DATE	
BY	
SURVEYED	
PLOTTED	
NOTE BOOK	
NO.	

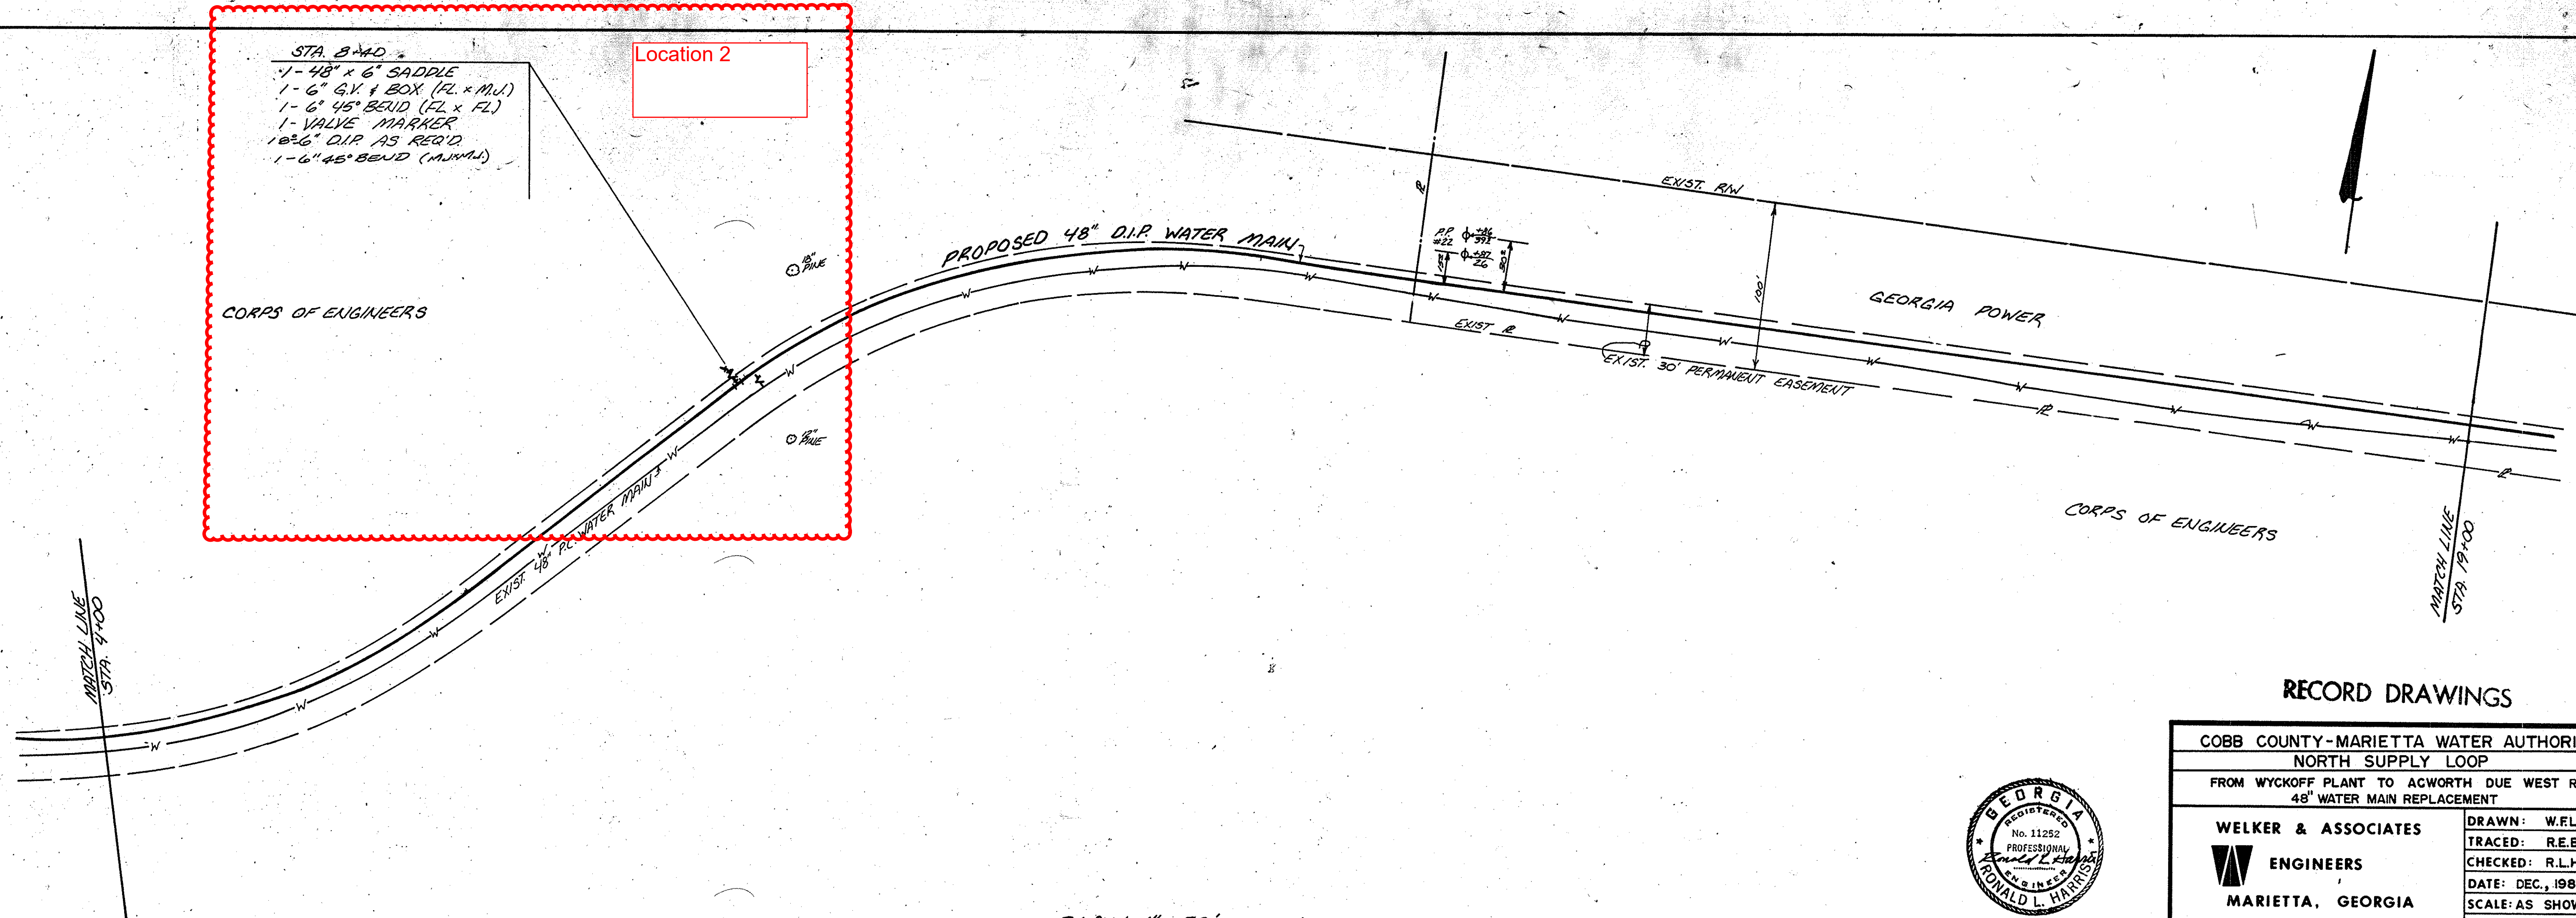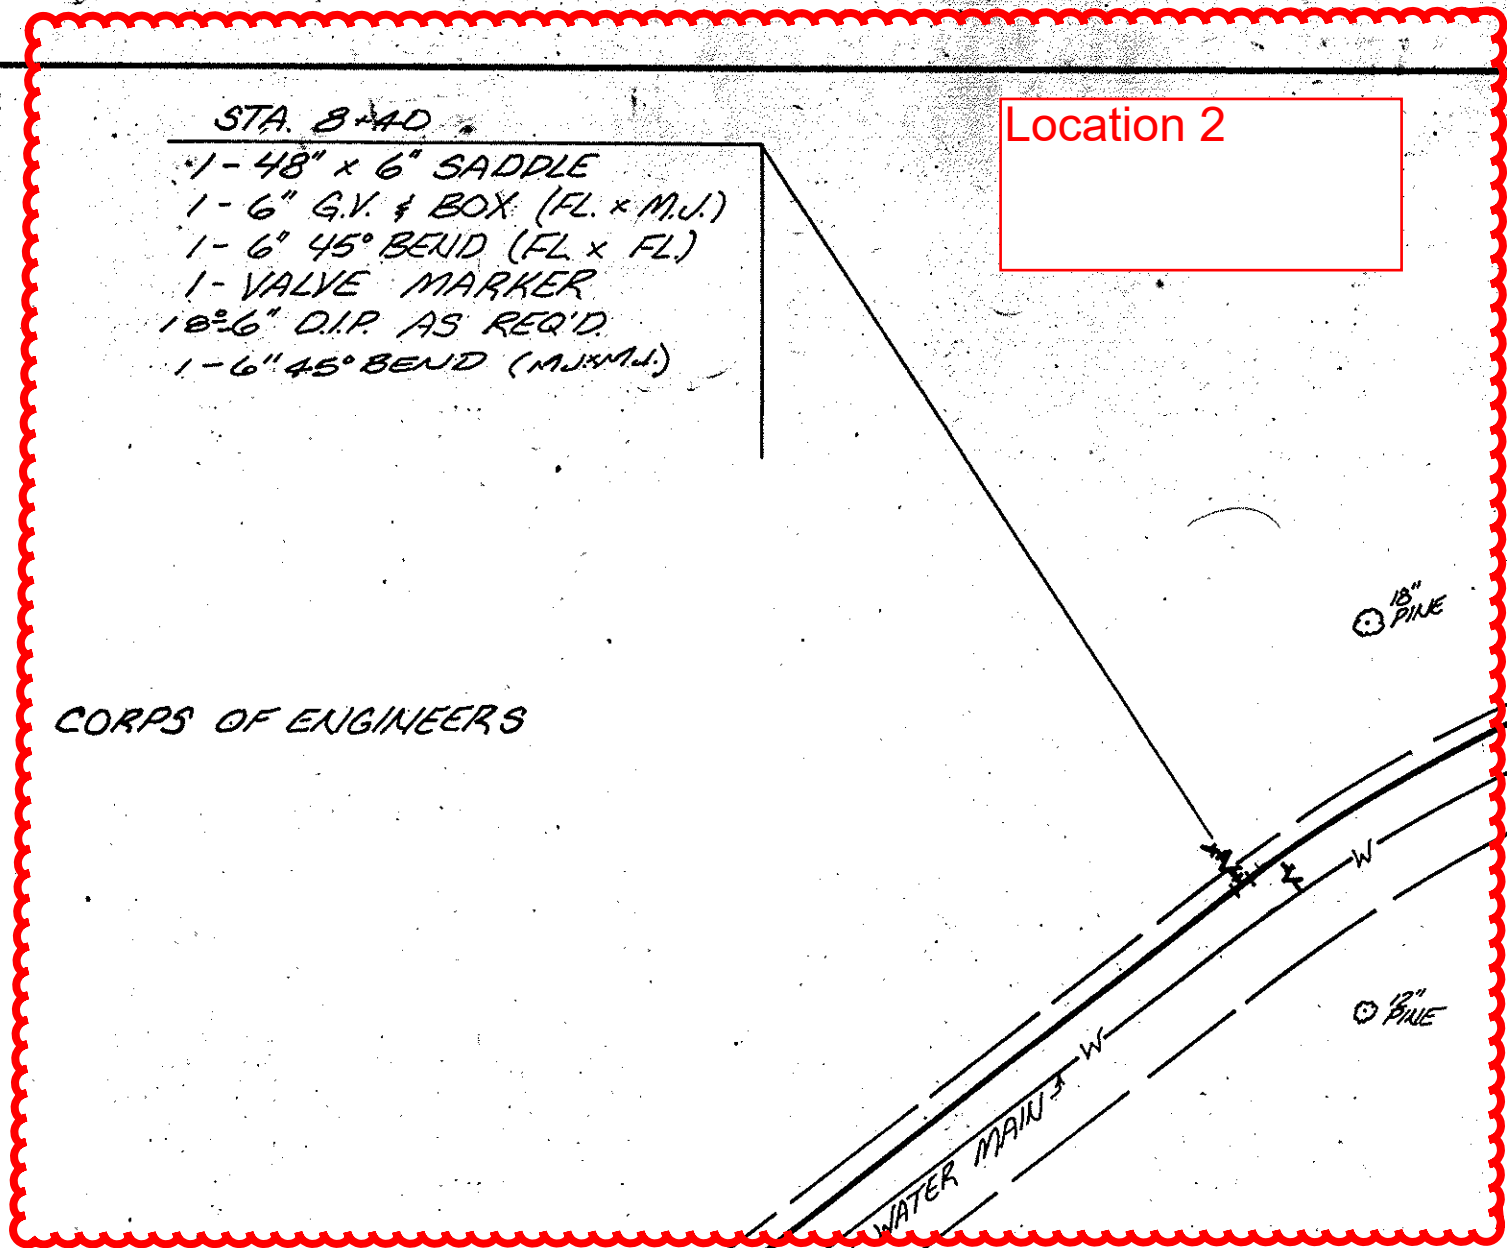

RECORD DRAWINGS

COBB COUNTY-MARIETTA WATER AUTHORITY
 NORTH SUPPLY LOOP
 FROM WYCKOFF PLANT TO ACWORTH DUE WEST RD.
 48" WATER MAIN REPLACEMENT

WELKER & ASSOCIATES
ENGINEERS
 MARIETTA, GEORGIA

DRAWN: W.F.L.
 TRACED: R.E.B.
 CHECKED: R.L.H.
 DATE: DEC, 1983
 SCALE: AS SHOWN
 SHEET: 83-480-4





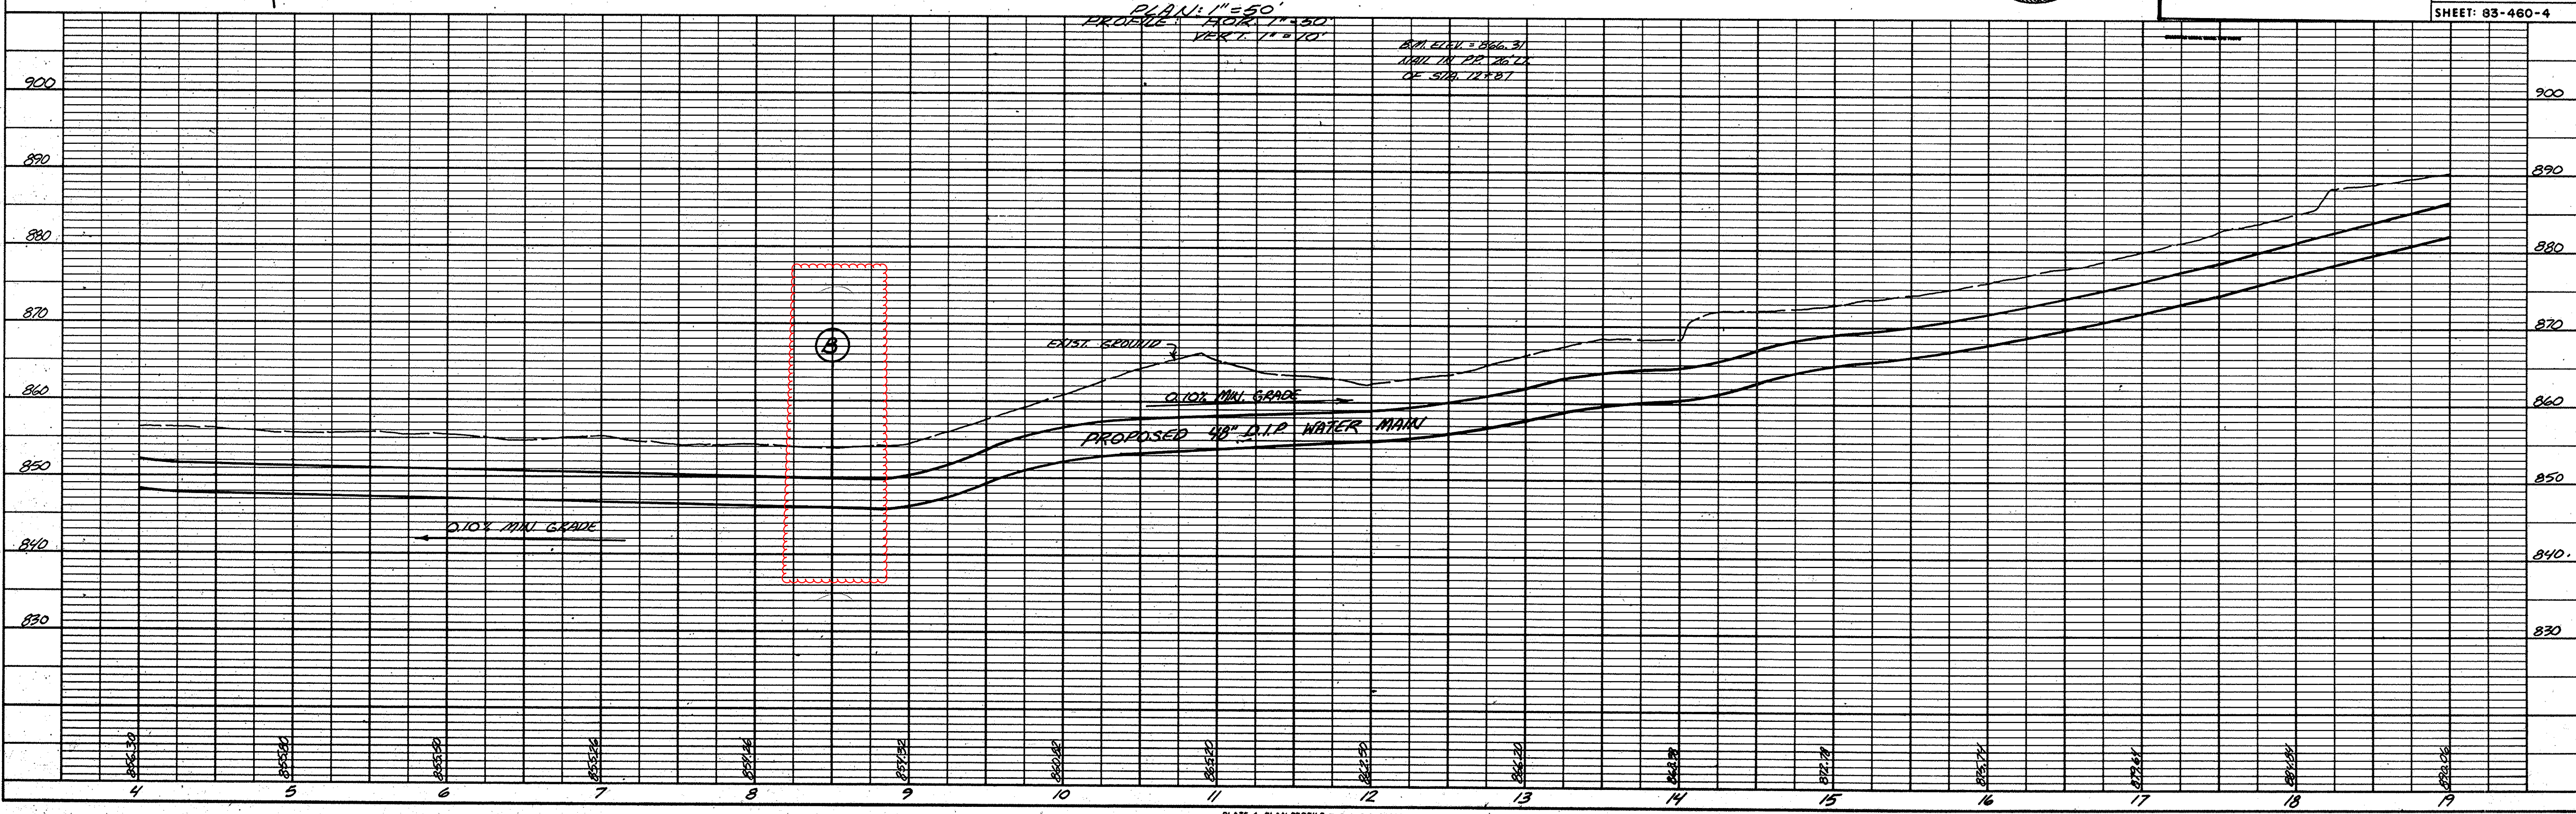


PLATE 1 PLAN-PROFILE O. P. R. & E. STANDARD
 DIETZGEN CORPORATION

DATE: _____ BY: _____
 PLAN NOTE BOOK No. _____

DATE: _____ BY: _____
 PROFILE NOTE BOOK No. _____

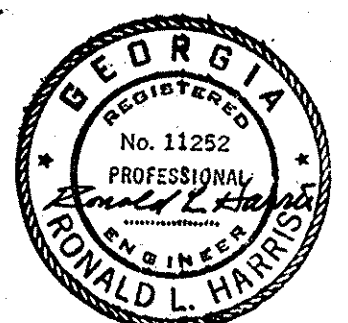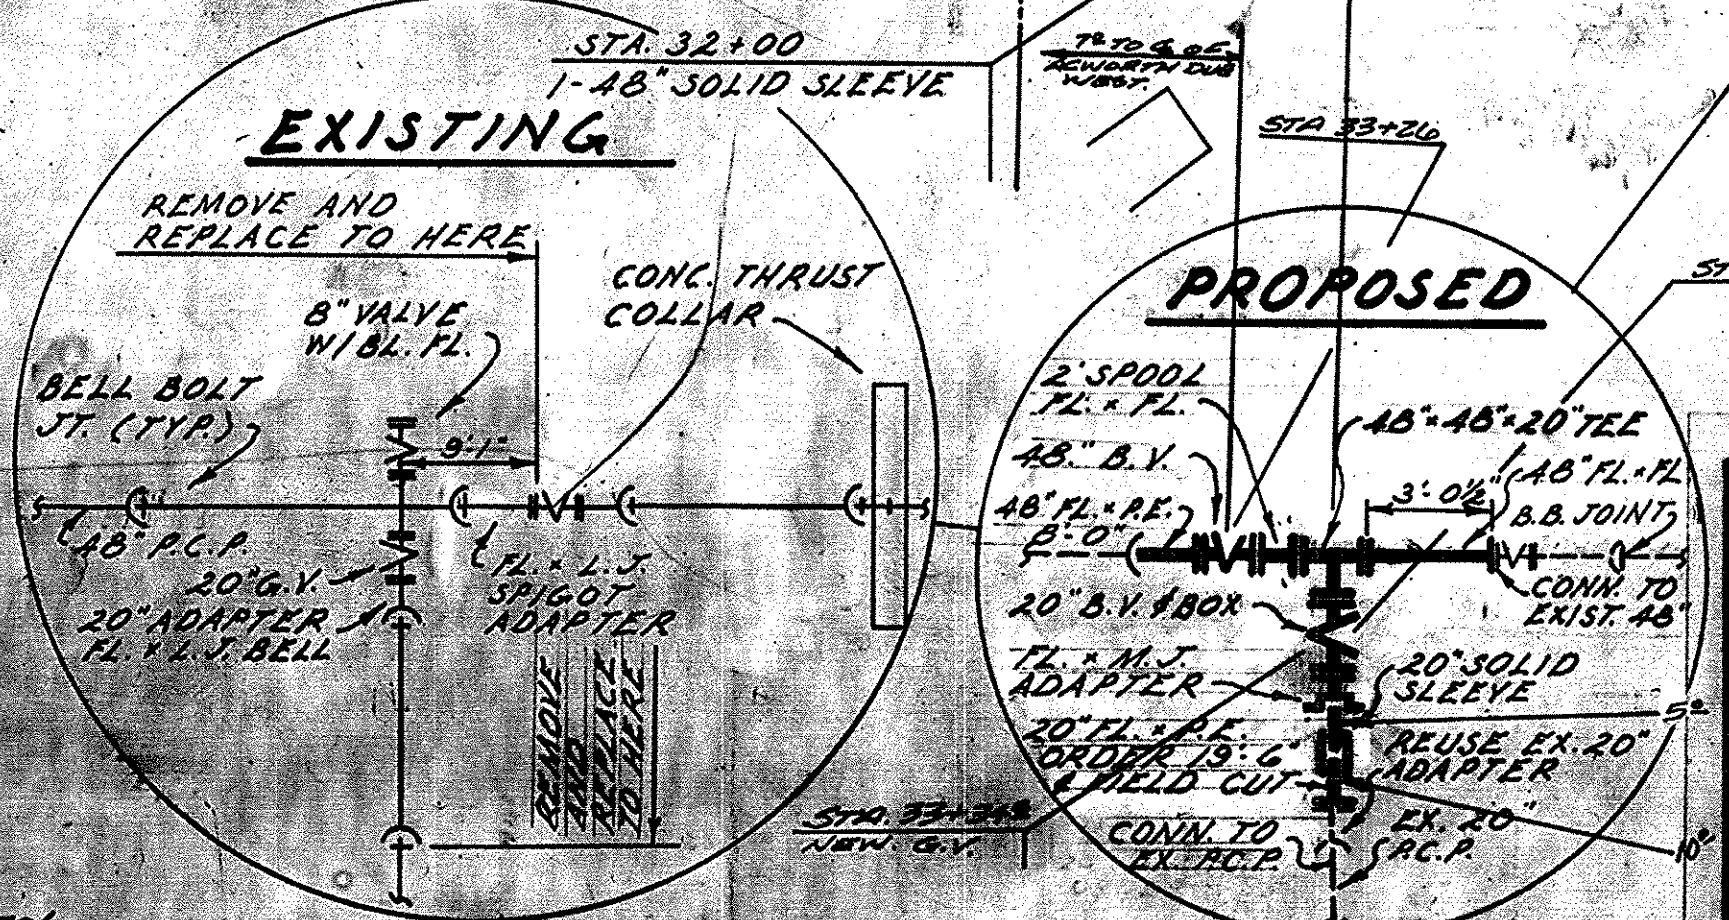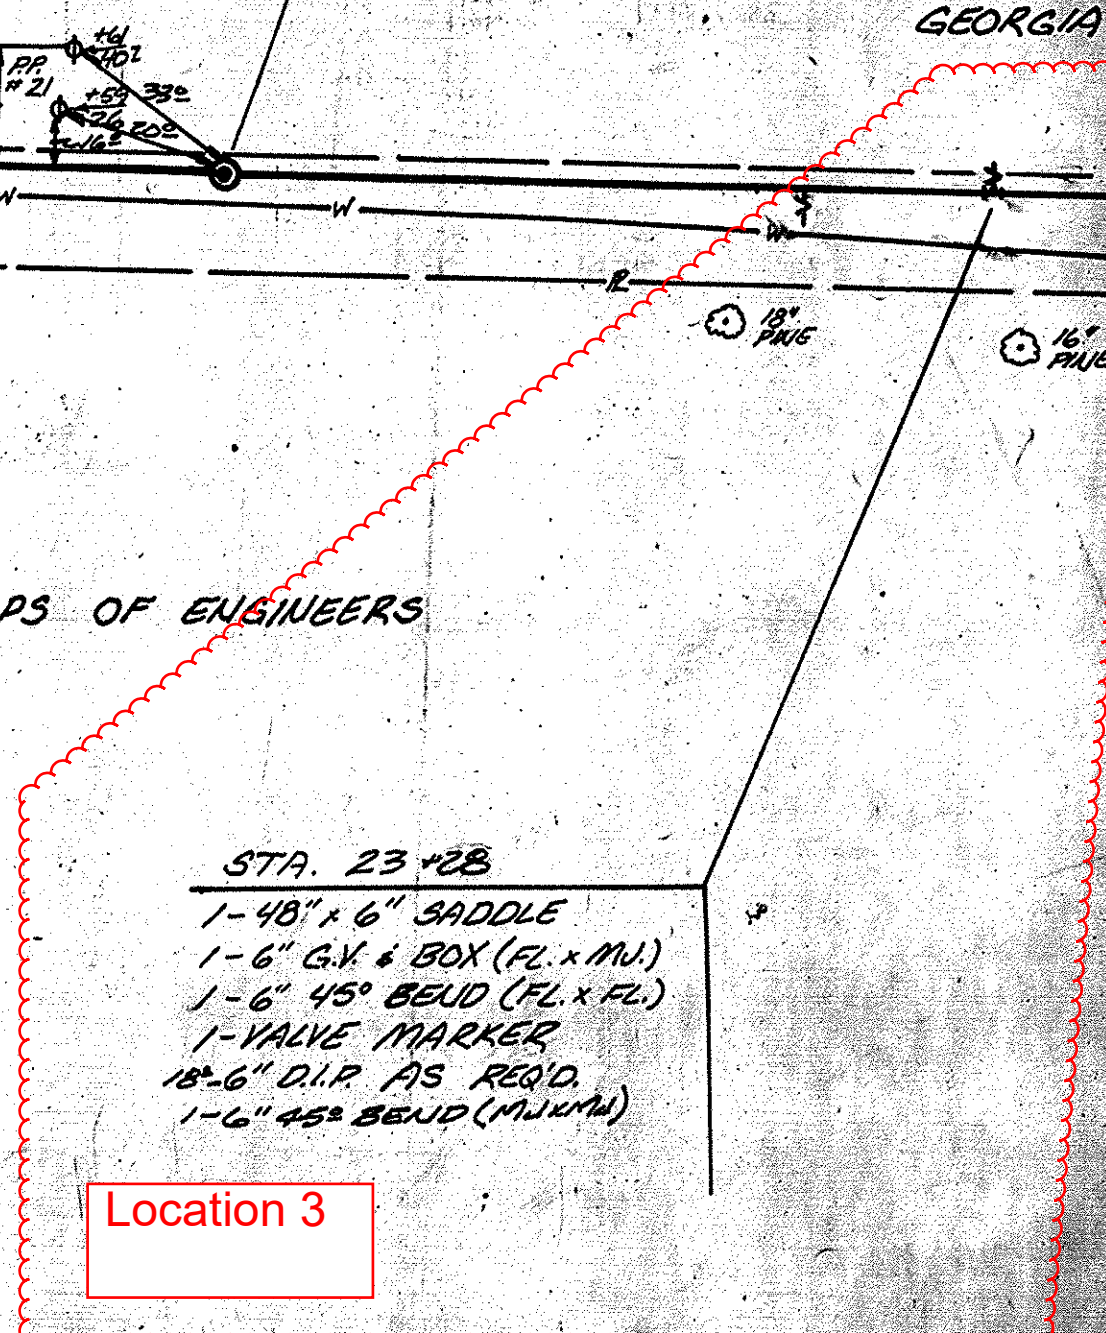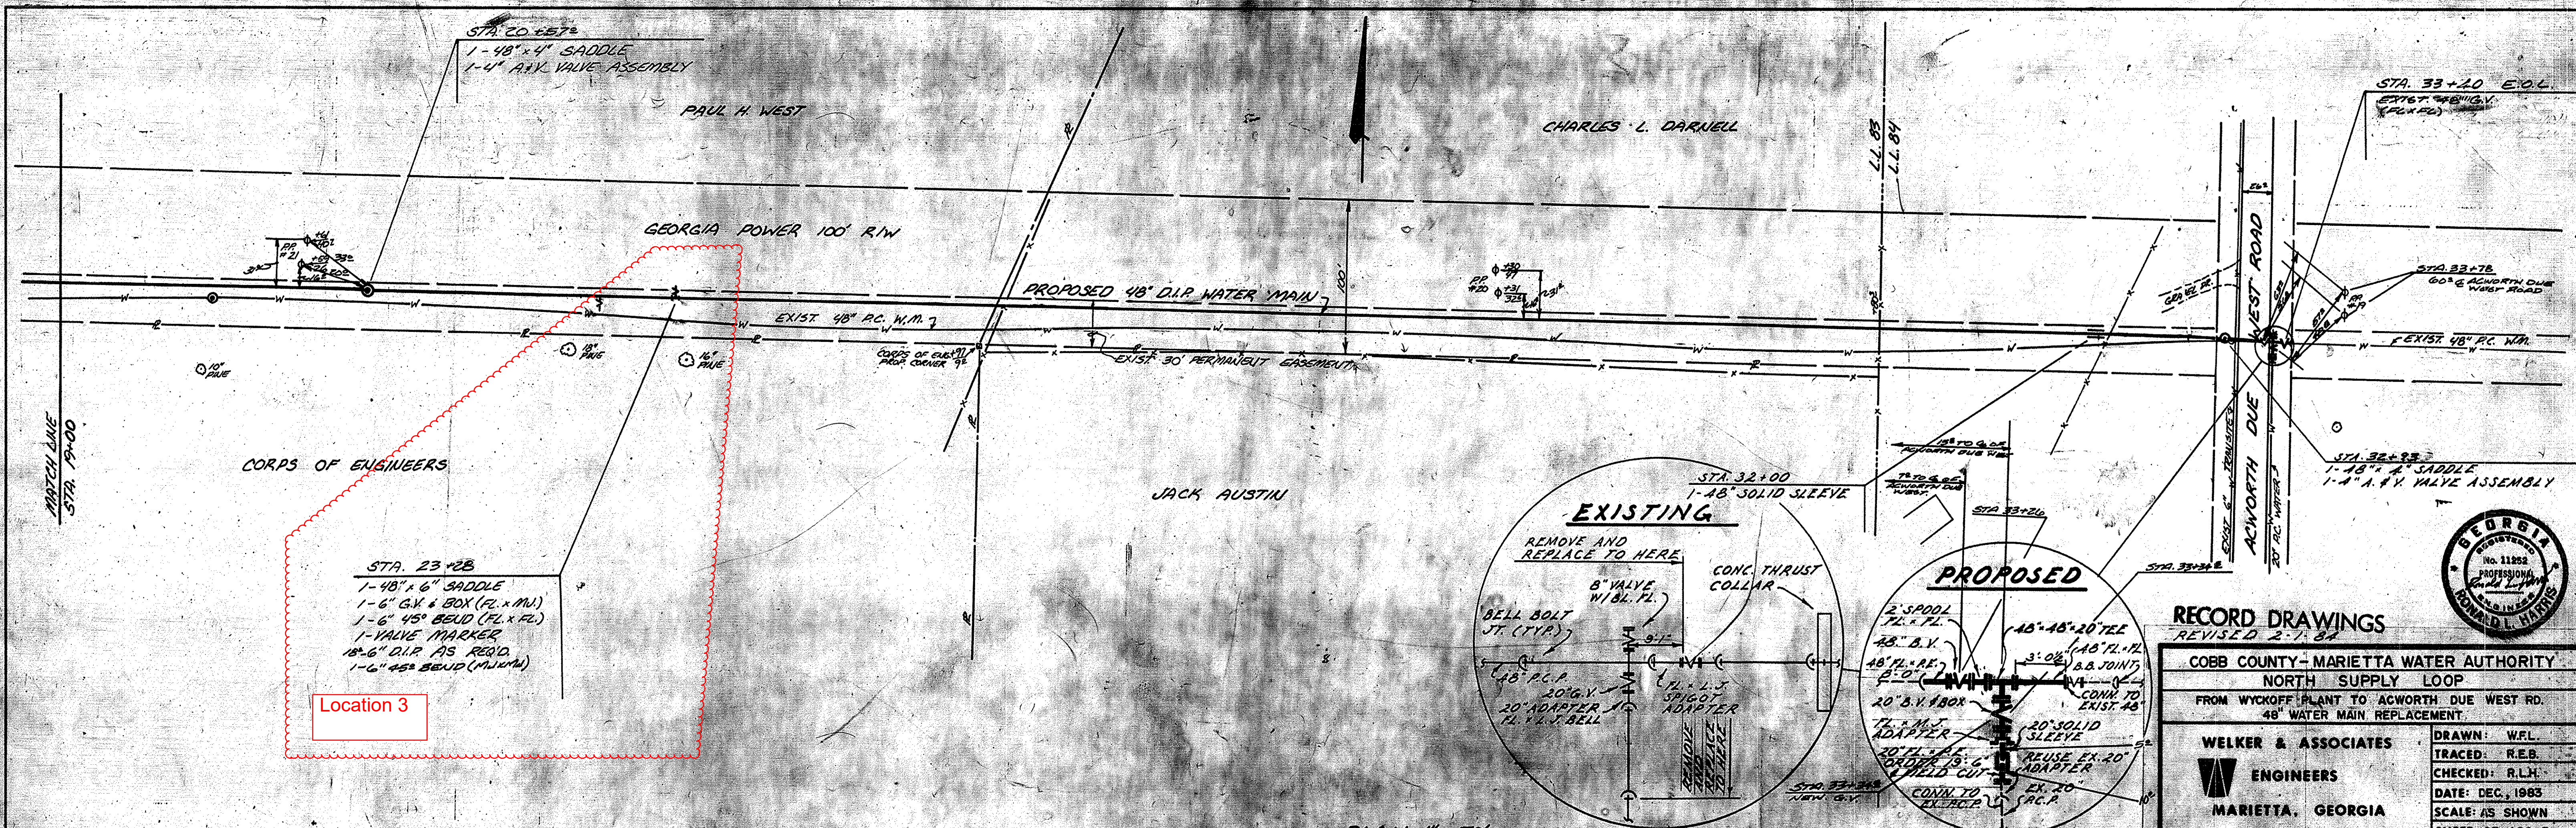


RECORD DRAWINGS
 REVISED 2-1-84


COBB COUNTY - MARIETTA WATER AUTHORITY
 NORTH SUPPLY LOOP
 FROM WYCKOFF PLANT TO ACWORTH DUE WEST RD.
 48" WATER MAIN REPLACEMENT.

WELKER & ASSOCIATES ENGINEERS
 MARIETTA, GEORGIA

PROFESSIONAL ENGINEER
 No. 11852
 DONALD L. HARRIS

DRAWN: W.F.L.
 TRACED: R.E.B.
 CHECKED: R.L.H.
 DATE: DEC, 1983
 SCALE: AS SHOWN
 SHEET: 83-480-5

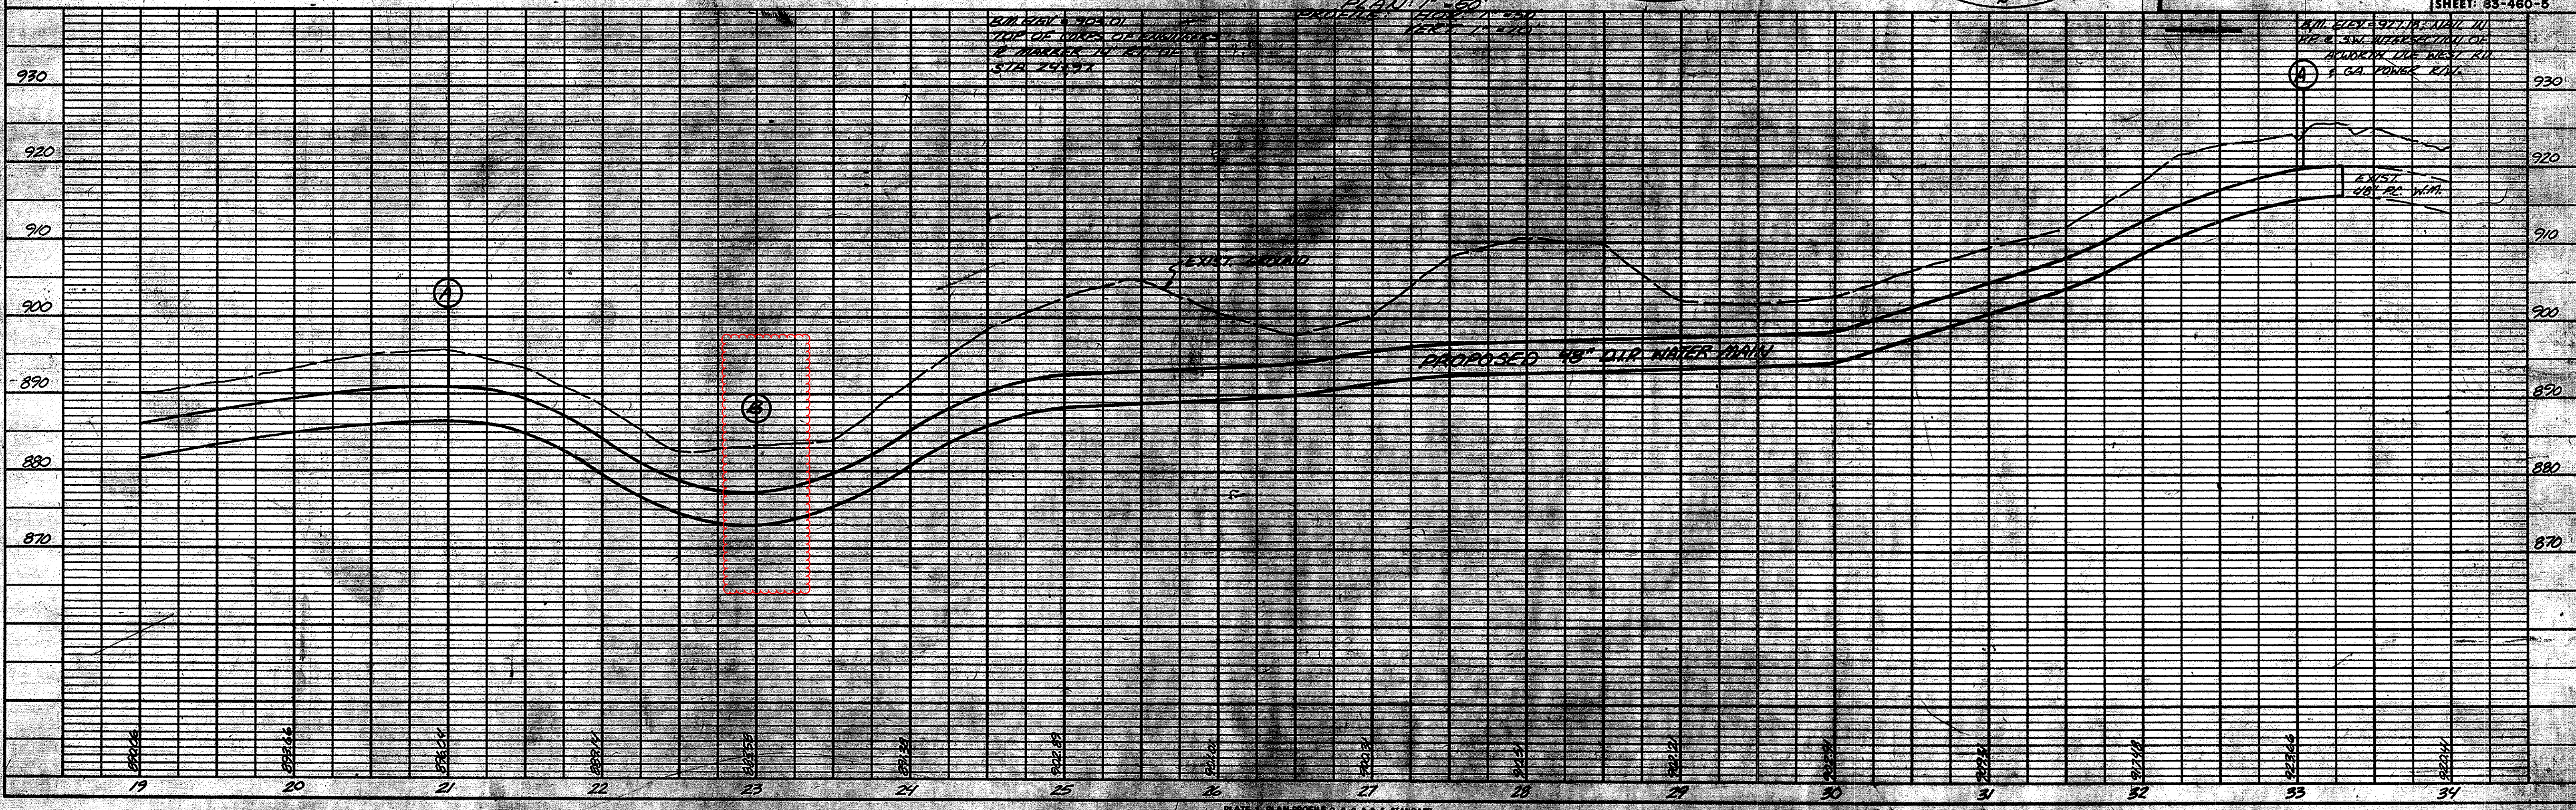

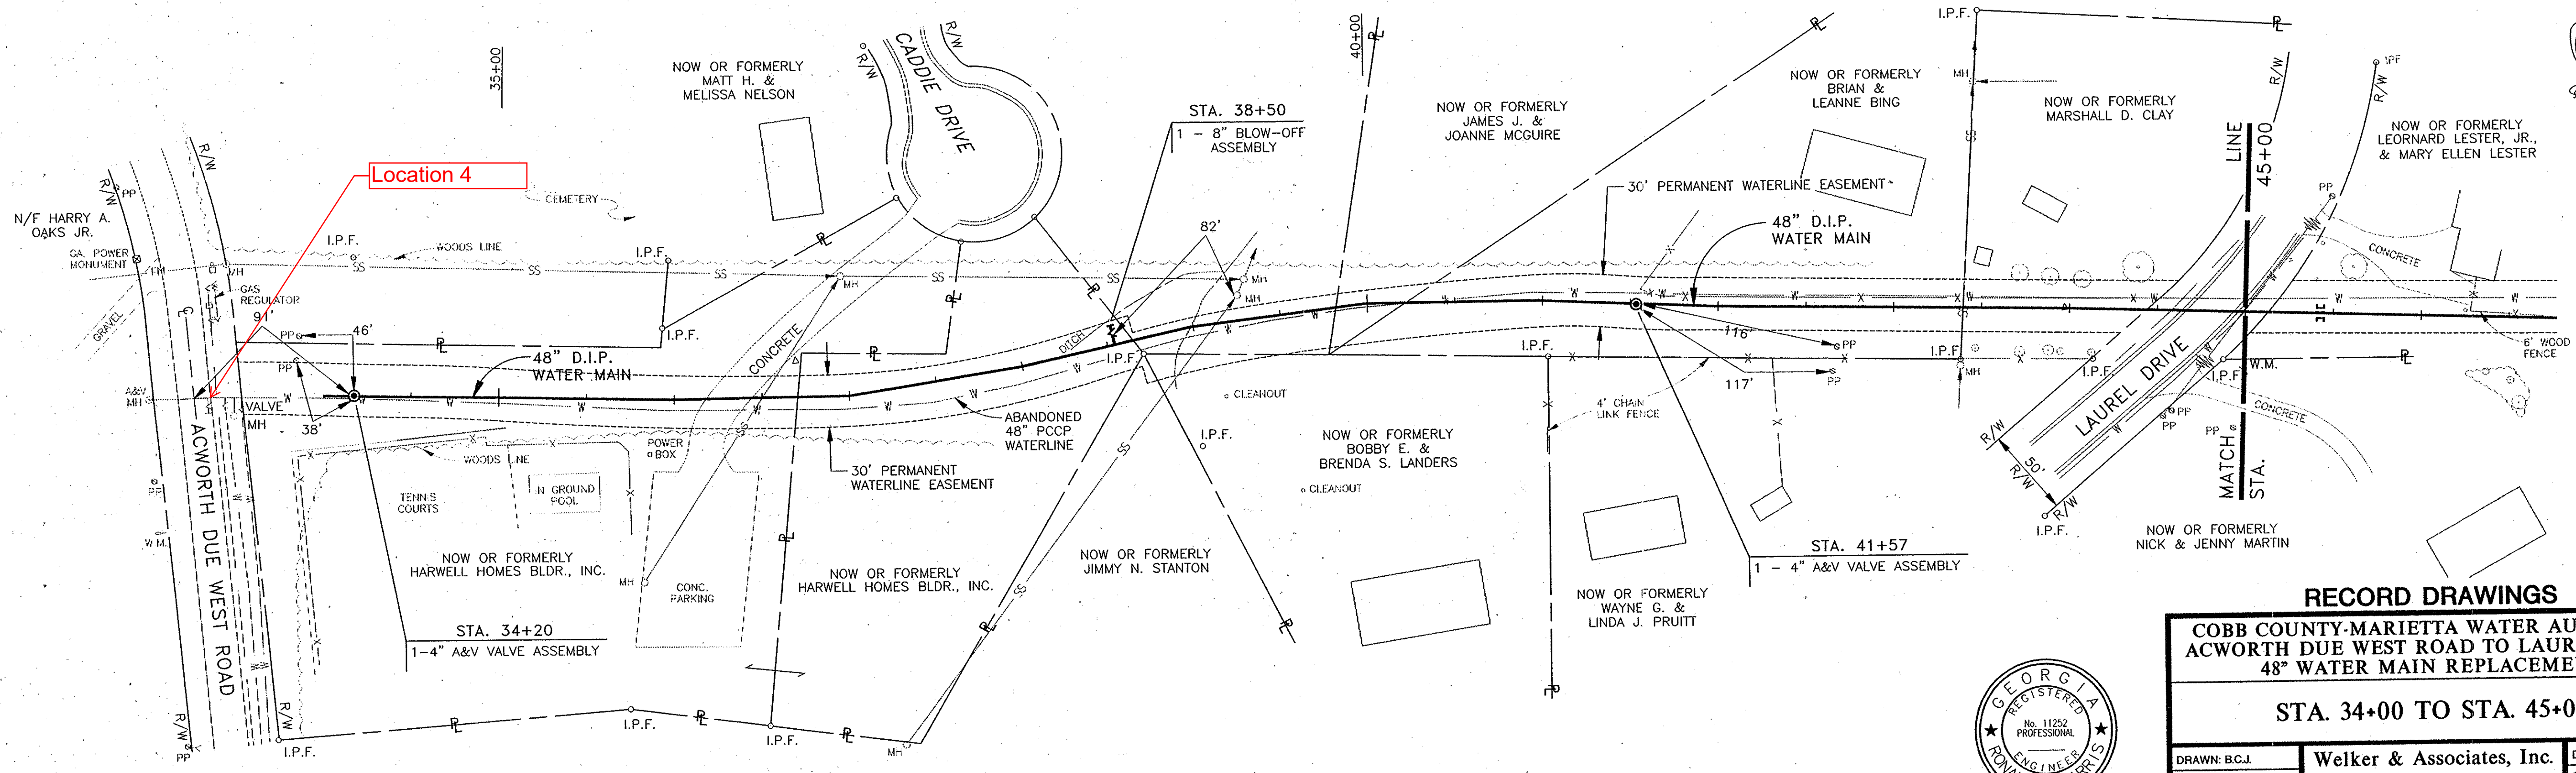


RECORD DRAWINGS

COBB COUNTY-MARIETTA WATER AUTHORITY
ACWORTH DUE WEST ROAD TO LAUREL DRIVE
48" WATER MAIN REPLACEMENT


STA. 34+00 TO STA. 45+00

DRAWN: BC.J	Welker & Associates, Inc.	DATE: APRIL 1996
DESIGNED: HAA	Engineers Since 1945	SCALE: AS SHOWN
CHECKED: RLH	445 Mangel Street Marietta, Georgia 30060 Phone: (770) 422-1902	JOB NO: 93-420
APPROVED: RLH		SHEET: 03

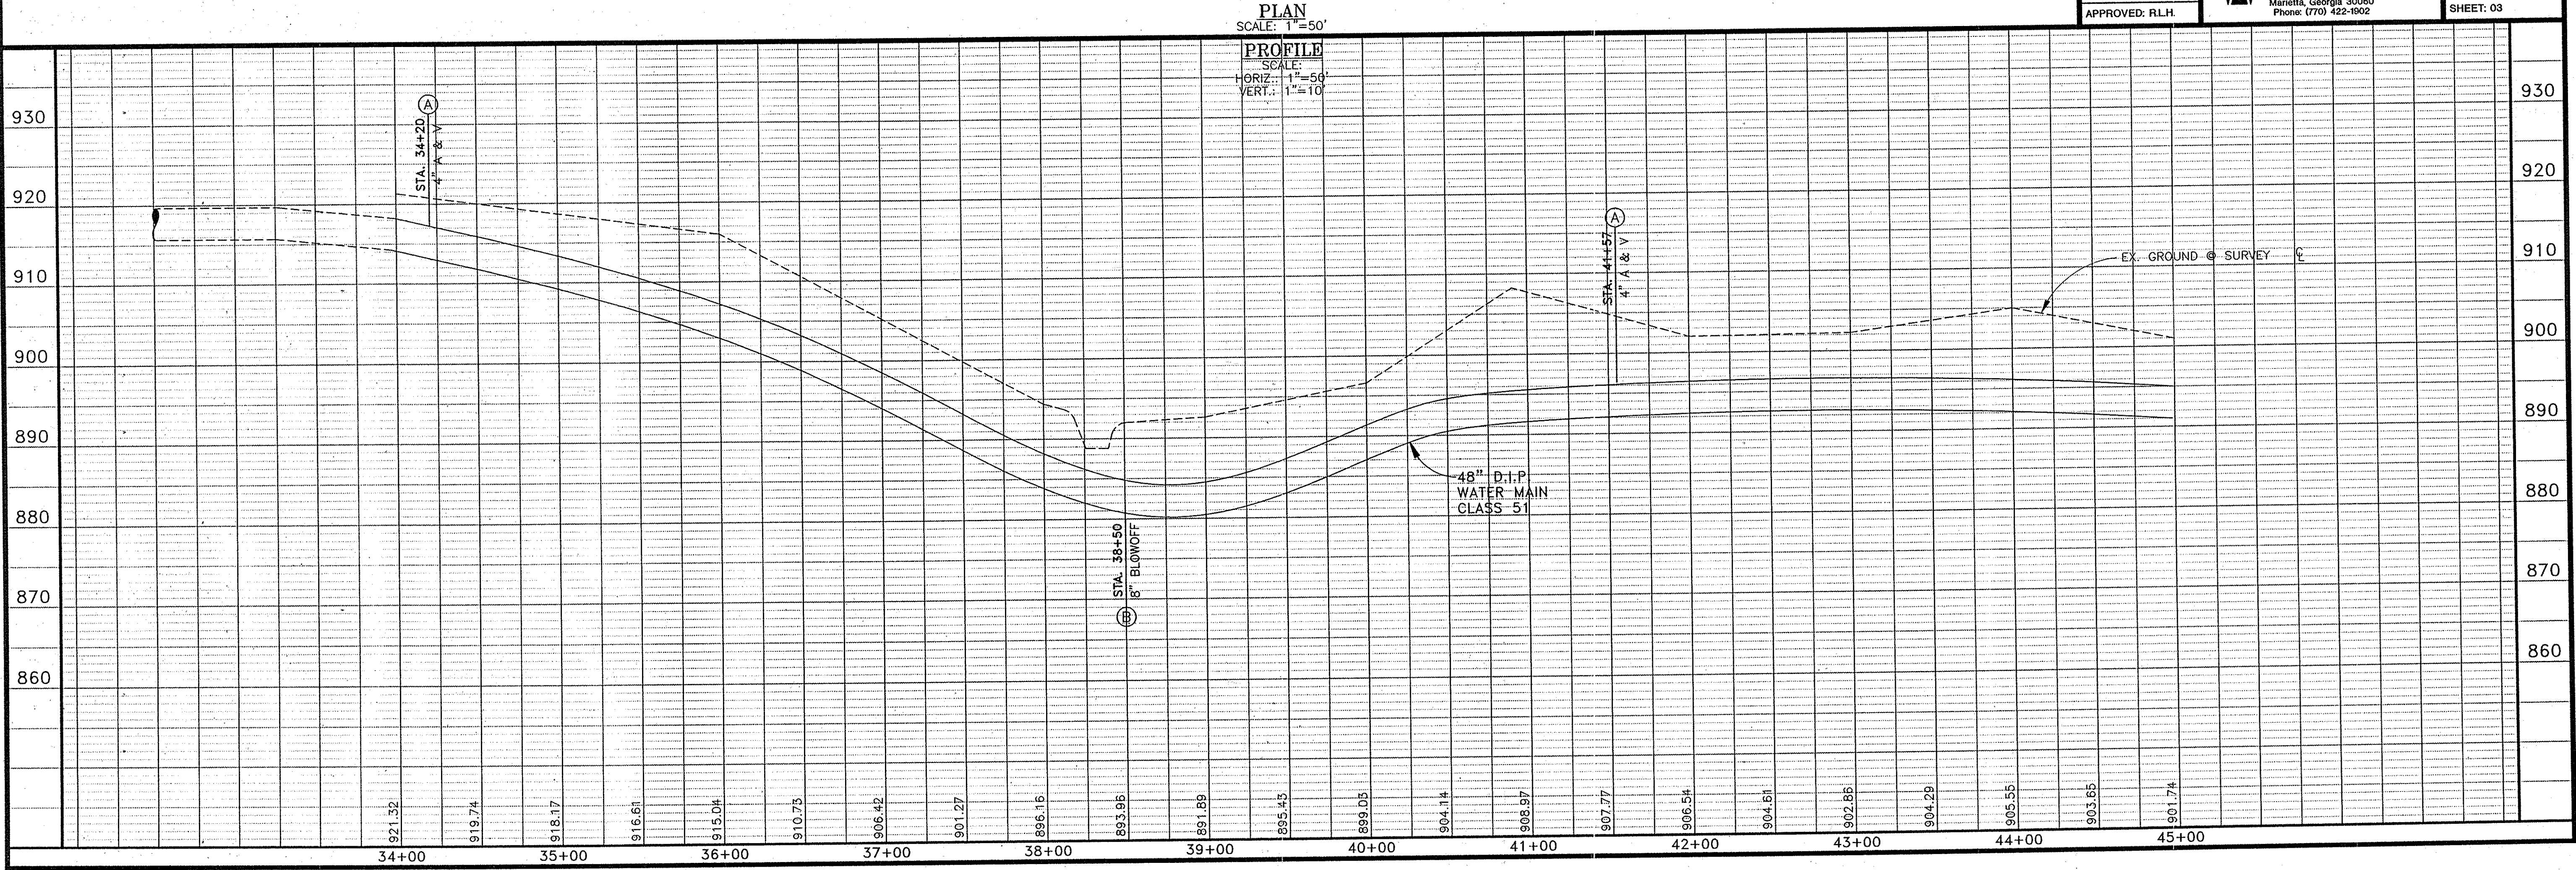


PLAN
 SURVEYED
 ALIGNMENT CHECKED
 ROUTE BOOK NO.
 DATE

PROFILE
 SURVEYED
 CHAINS CHECKED
 B.M.'S NOTED
 STRUCTURE NOTATIONS CHECKED
 DATE

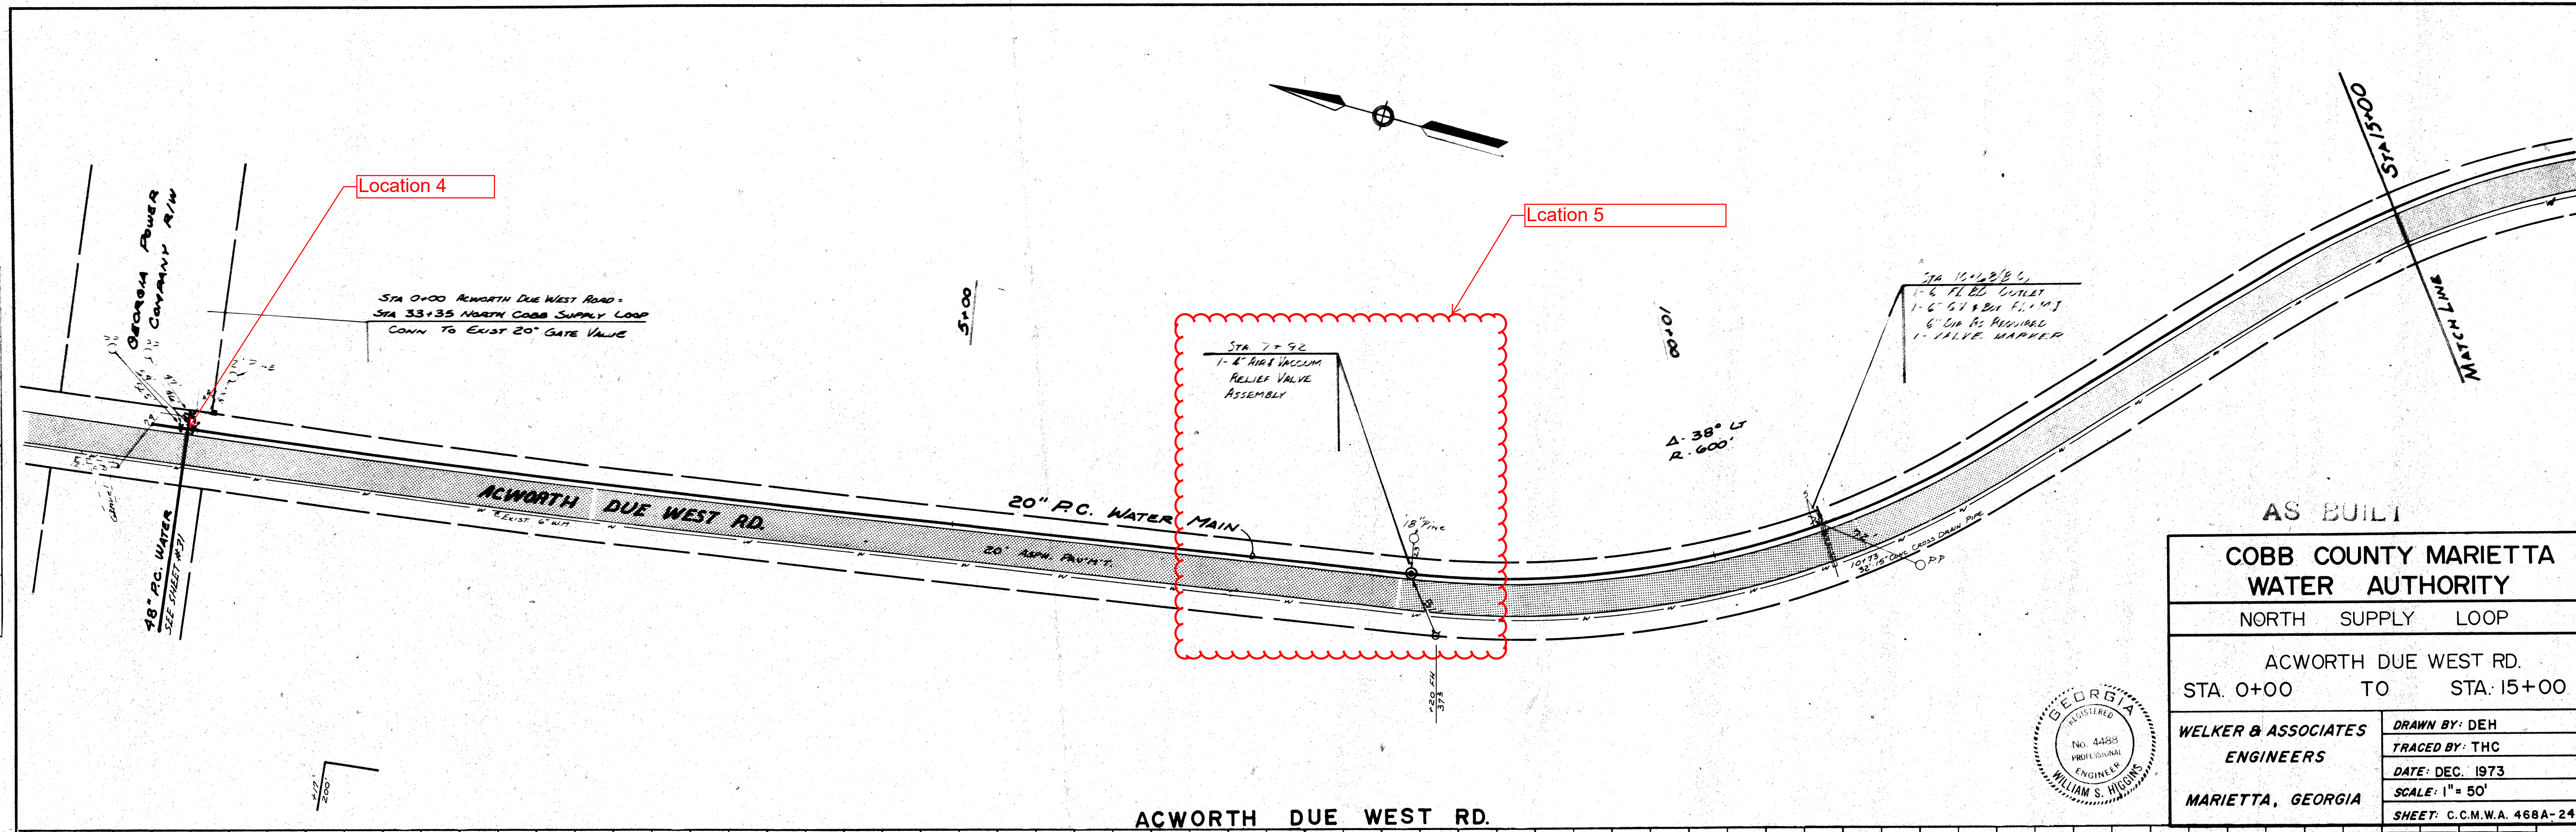



PLAN
 SURVEYED: _____
 NOTE BOOK: _____
 NO. _____
 DATE: _____
 BY: _____
 CHECKED: _____
 DATE: _____

PROFILE
 SURVEYED: _____
 NOTE BOOK: _____
 NO. _____
 DATE: _____
 BY: _____
 CHECKED: _____
 DATE: _____

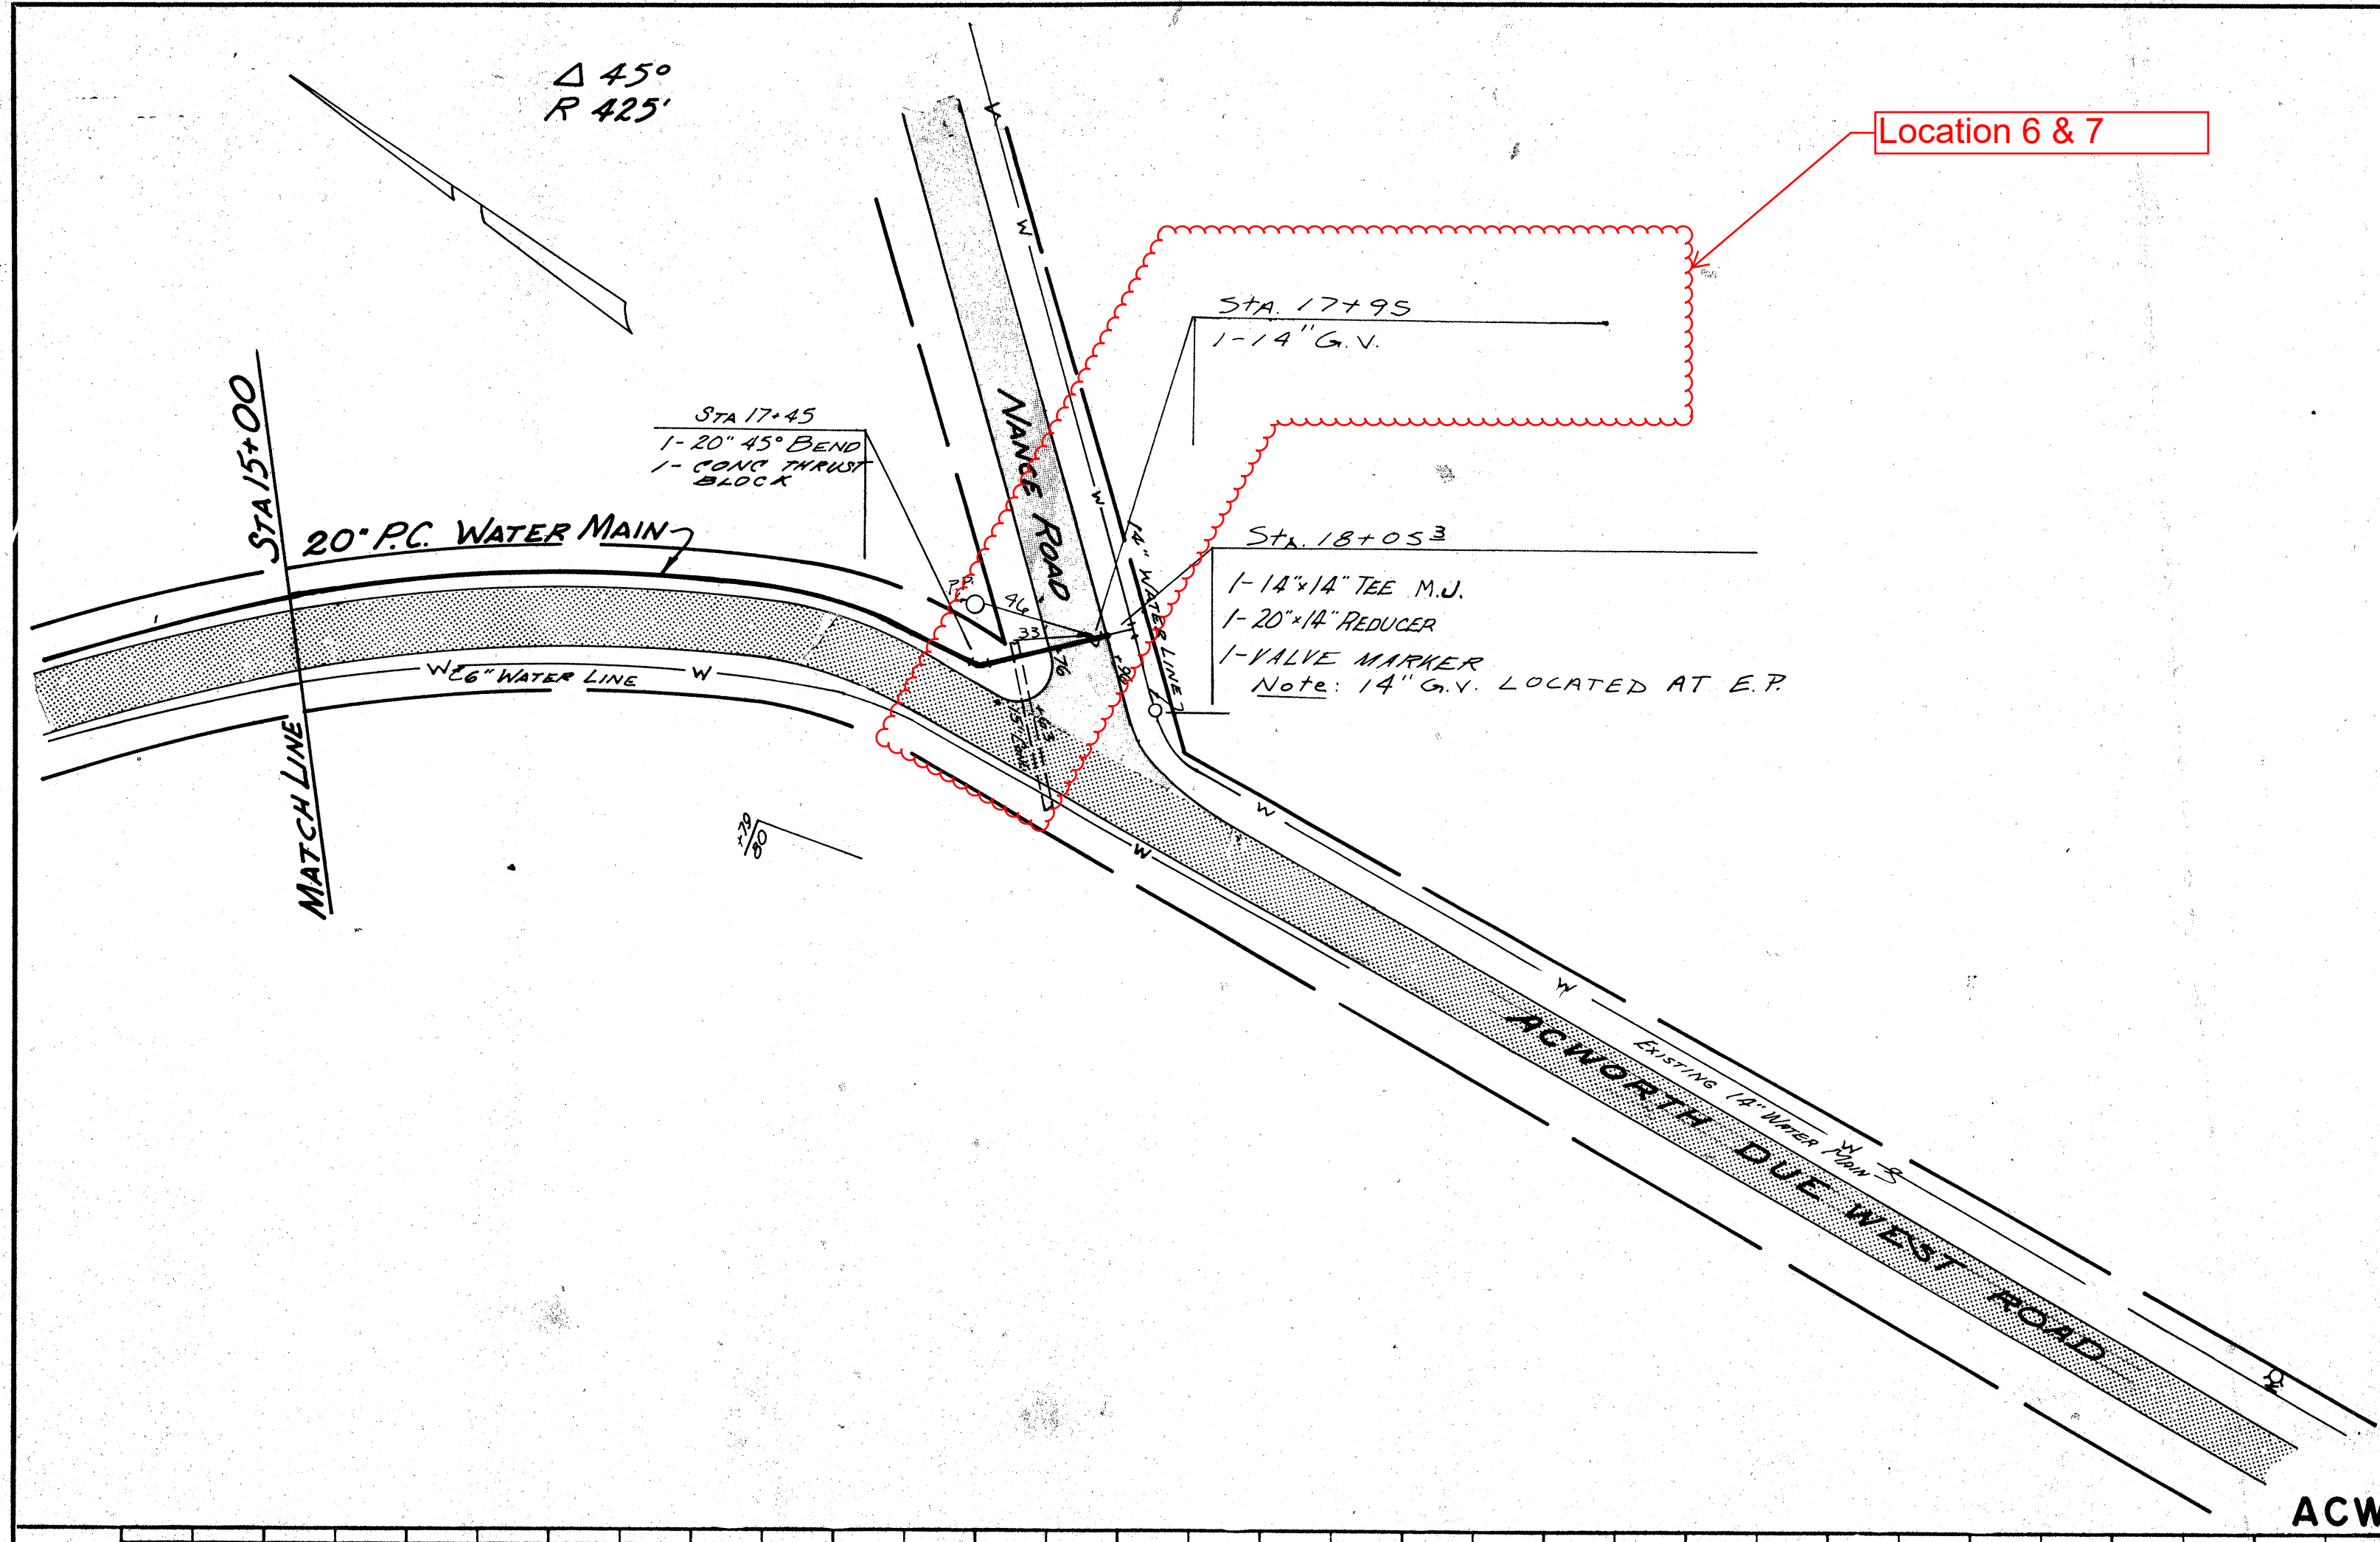

AS BUILT


COBB COUNTY MARIETTA WATER AUTHORITY	
NORTH SUPPLY LOOP	
ACWORTH DUE WEST RD. STA. 15+00 TO STA. 18+05.30	
WELKER & ASSOCIATES ENGINEERS MARIETTA, GEORGIA	DRAWN BY: DEH TRACED BY: THC DATE: DEC. 1973 SCALE: 1" = 50' SHEET: C.C.M.W.A. 468 A-25

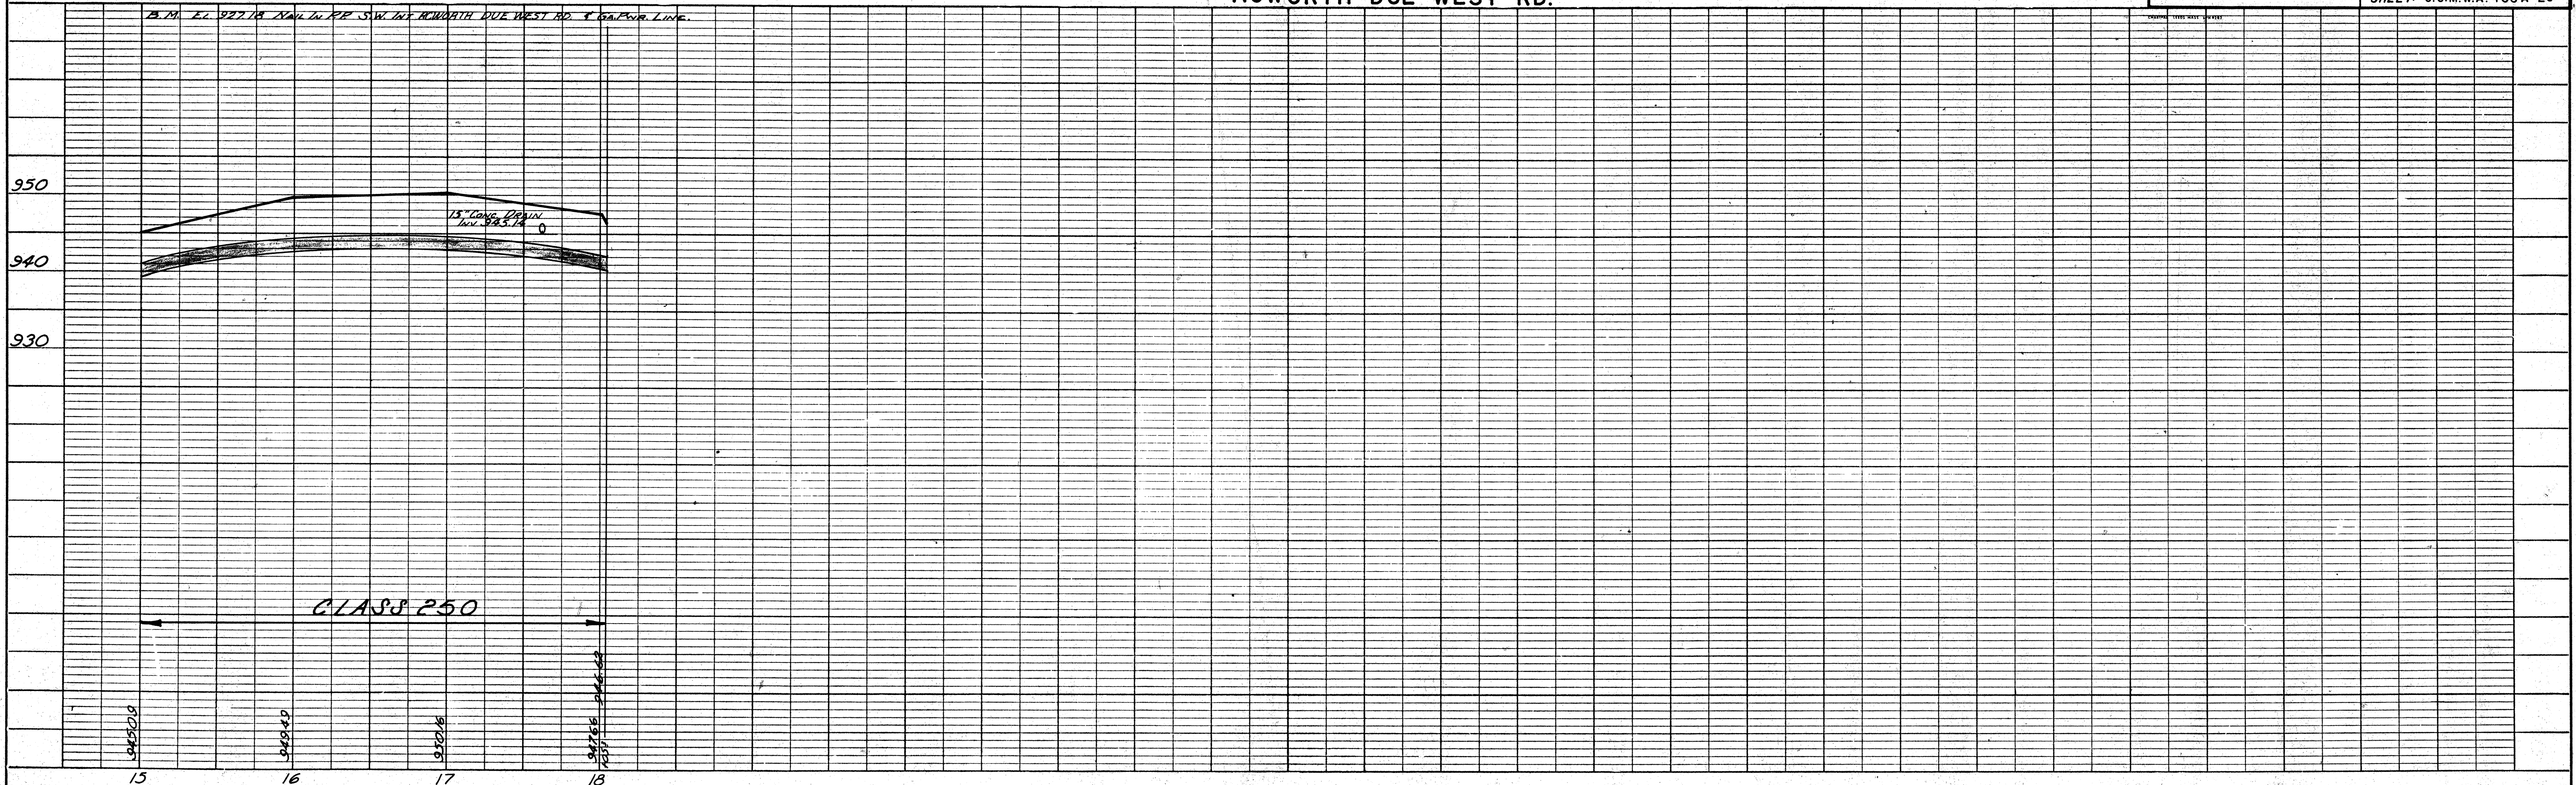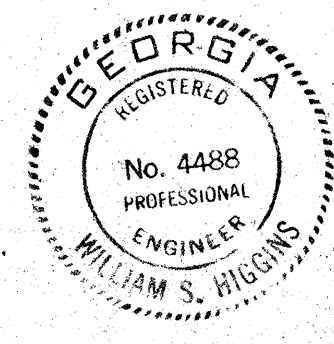


ACWORTH DUE WEST RD.


DATE	
BY	
REVISIONS	
NO.	
PLAN	
NO. 1	
NO. 2	

DATE	
BY	
REVISIONS	
NO.	
PROFILE	
NO. 1	
NO. 2	

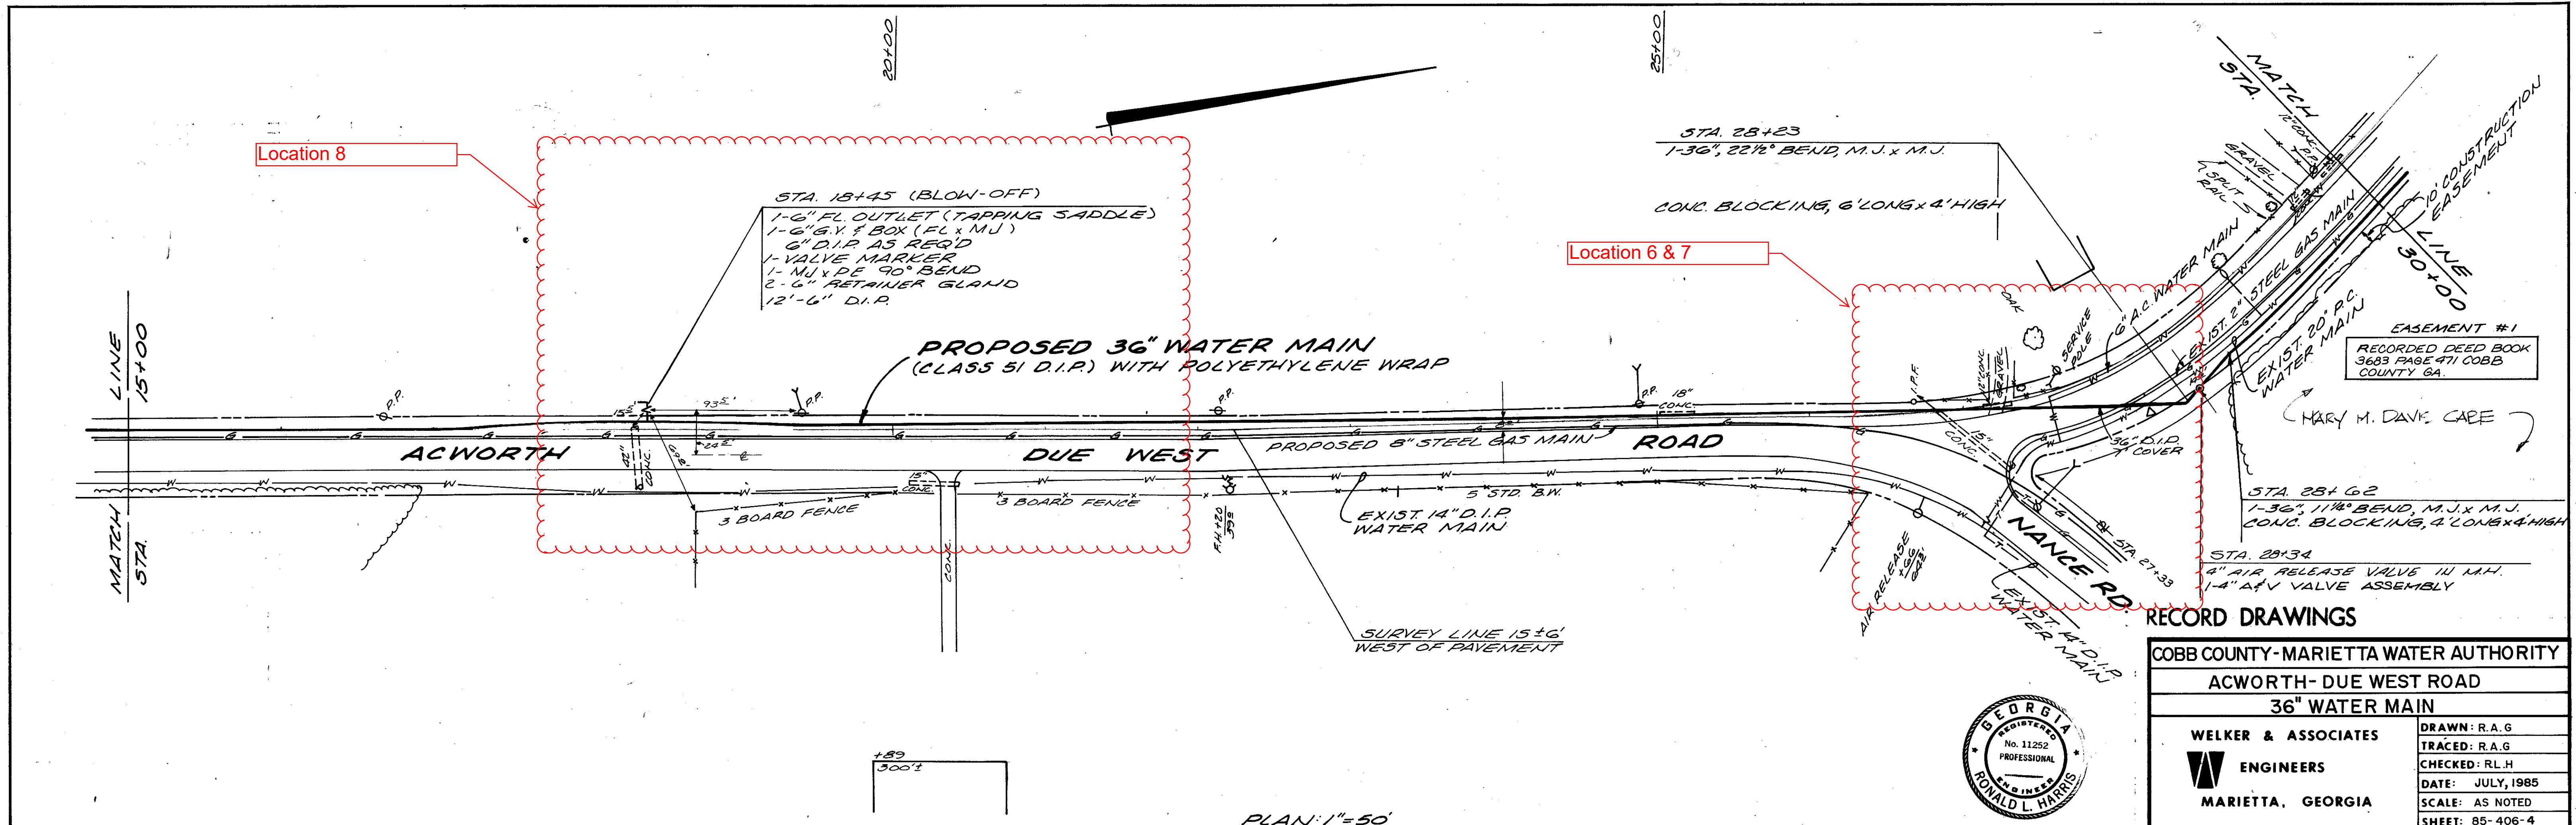

RECORD DRAWINGS	
COBB COUNTY-MARIETTA WATER AUTHORITY	
ACWORTH-DUE WEST ROAD	
36" WATER MAIN	
WELKER & ASSOCIATES ENGINEERS MARIETTA, GEORGIA	DRAWN: R.A.G. TRACED: R.A.G. CHECKED: R.L.H. DATE: JULY, 1985 SCALE: AS NOTED SHEET: 85-406-4

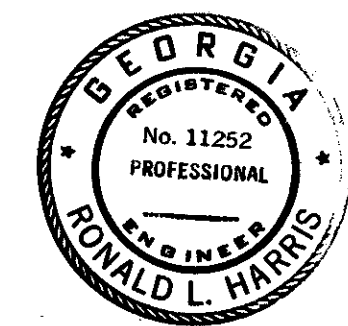

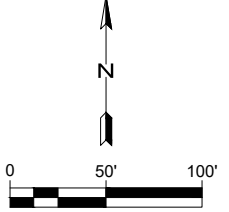

- NOTES:
1. CONTRACTOR SHALL INSTALL RIP RAP ALONG ENTIRE WIDTH OF THE EXISTING CHANNEL FOR THE LENGTH WITHIN THE 30' PERMANENT EASEMENT. RIP RAP SHALL BE INSTALLED SUCH THAT IT DOES NOT DAM THE FLOW IN THE CHANNEL. CONTRACTOR SHALL RE-GRADE CHANNEL BANKS AS REQUIRED FOR PROPER RIP RAP PLACEMENT. EXISTING JOINT OF DUCTILE IRON PIPE LYING IN THE CHANNEL SHALL BE REMOVED AND DISPOSED OF IN A LEGAL MANNER.
 2. ALL NEW PIPE/FITTINGS ARE ZINC COATED AND DOUBLE POLY-WRAPPED WITH BLACK 8-MIL OUTER LAYER AND WHITE 4-MIL V-BIO INNER LAYER.
 3. EXISTING 48\" DIP MAY HAVE DIFFERENT O.D. CONTRACTOR TO FIELD VERIFY PIPE O.D. PRIOR TO ORDERING MATERIALS.

DESIGNED BY: DE
 DRAWN BY: DE
 REVIEWED BY: JRF

BAR BELOW IS 1" LONG FOR EACH FOOT OF LENGTH. IF NOT 1" LONG ON THIS SHEET, ADJUST SCALES ACCORDINGLY.

PROJECT NUMBER: 505-9005-38-20-0000
 PROJECT DATE: OCTOBER 2020


REVISION	DATE

ESI
 ENGINEERING STRATEGIES, INC.

COBB COUNTY-MARIETTA WATER AUTHORITY
 2021 BLOW-OFF REPLACEMENTS


LOCATIONS 1, 2 AND 3

2

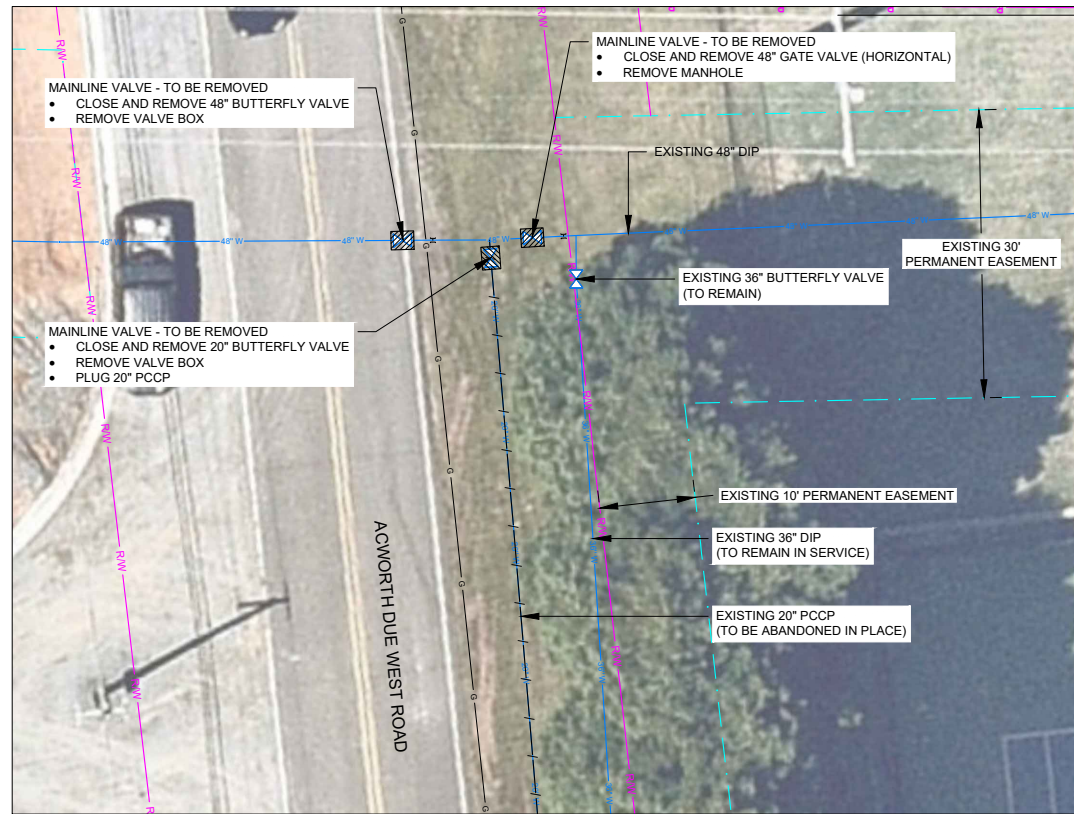

LOCATION No. 4 (EXISTING)


1" = 10'

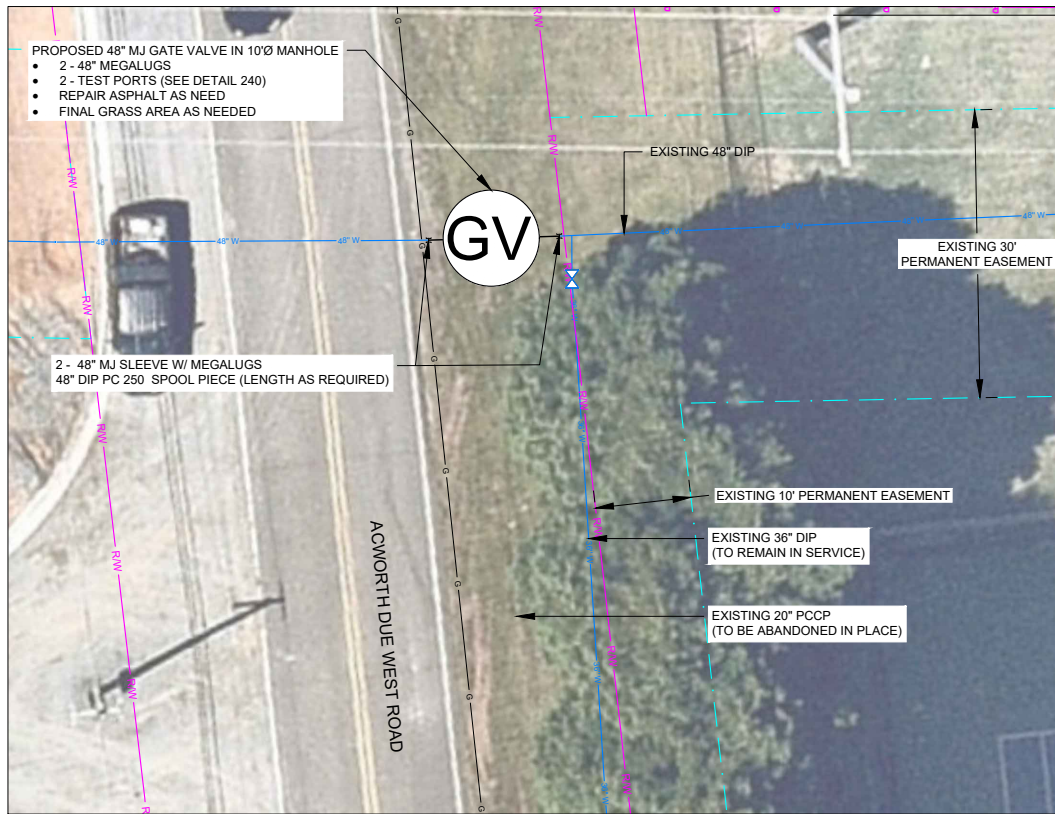

LOCATION No. 4 (PROPOSED)


1" = 10'

NOTES:
 1. ALL NEW PIPE/FITTINGS ARE ZINC COATED AND DOUBLE POLY-WRAPPED WITH BLACK 8-MIL OUTER LAYER AND WHITE 4-MIL V-BIO INNER LAYER.

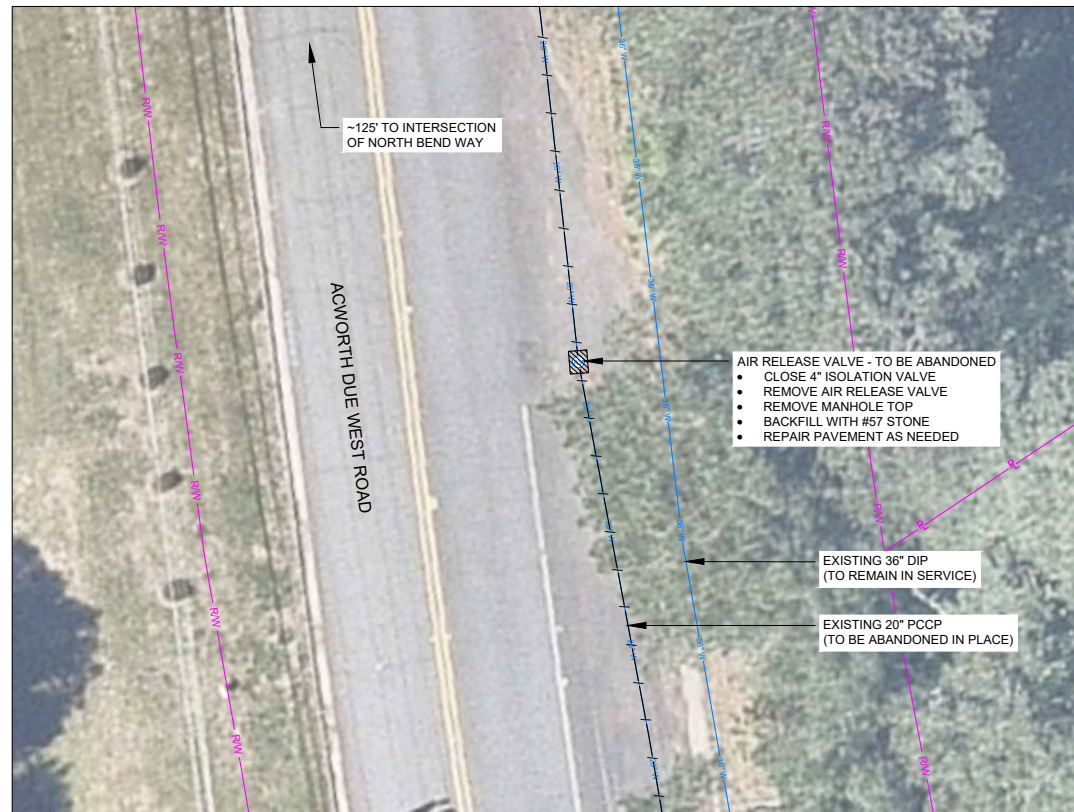

LOCATION No. 5

1" = 10'

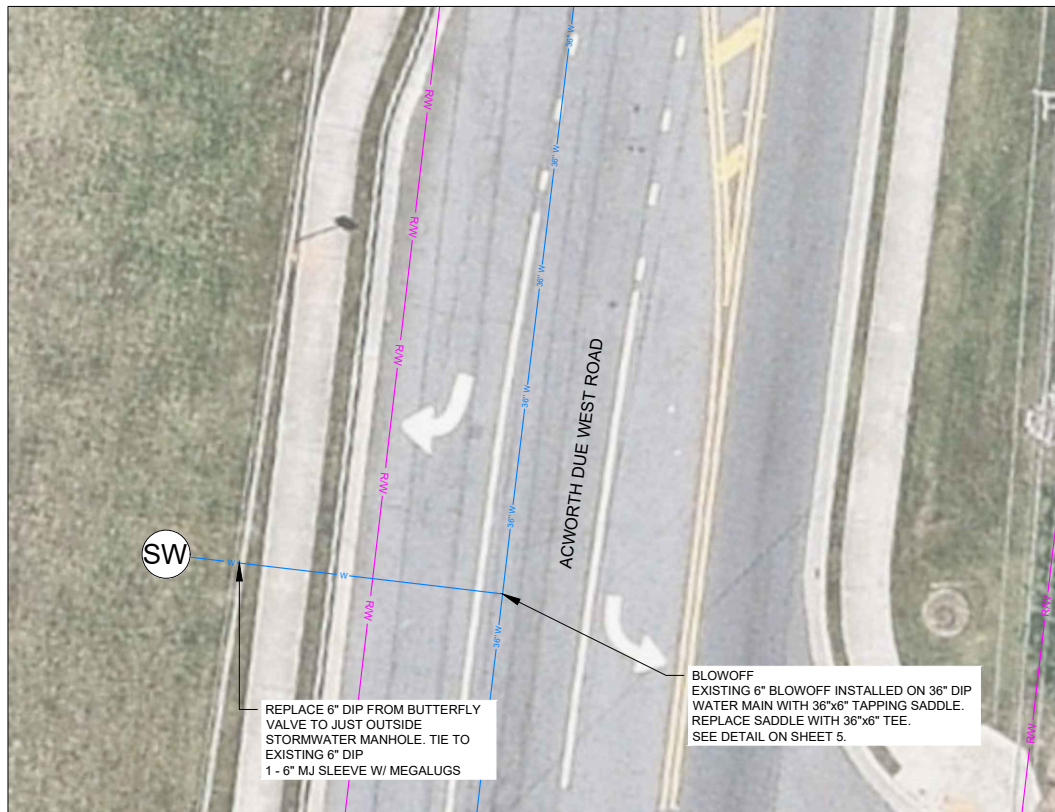

LOCATION No. 8



1" = 10'

PROJECT NUMBER: 505-9005-38-20-0000
 PROJECT DATE: OCTOBER 2020

DESIGNED BY:	DE
DRAWN BY:	DE
REVIEWED BY:	JRF

COBB COUNTY-MARIETTA WATER AUTHORITY
 2021 BLOW-OFF REPLACEMENTS
 LOCATIONS 3, 4, 6, AND 9



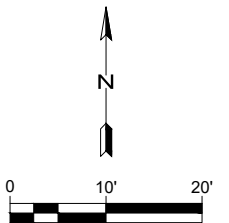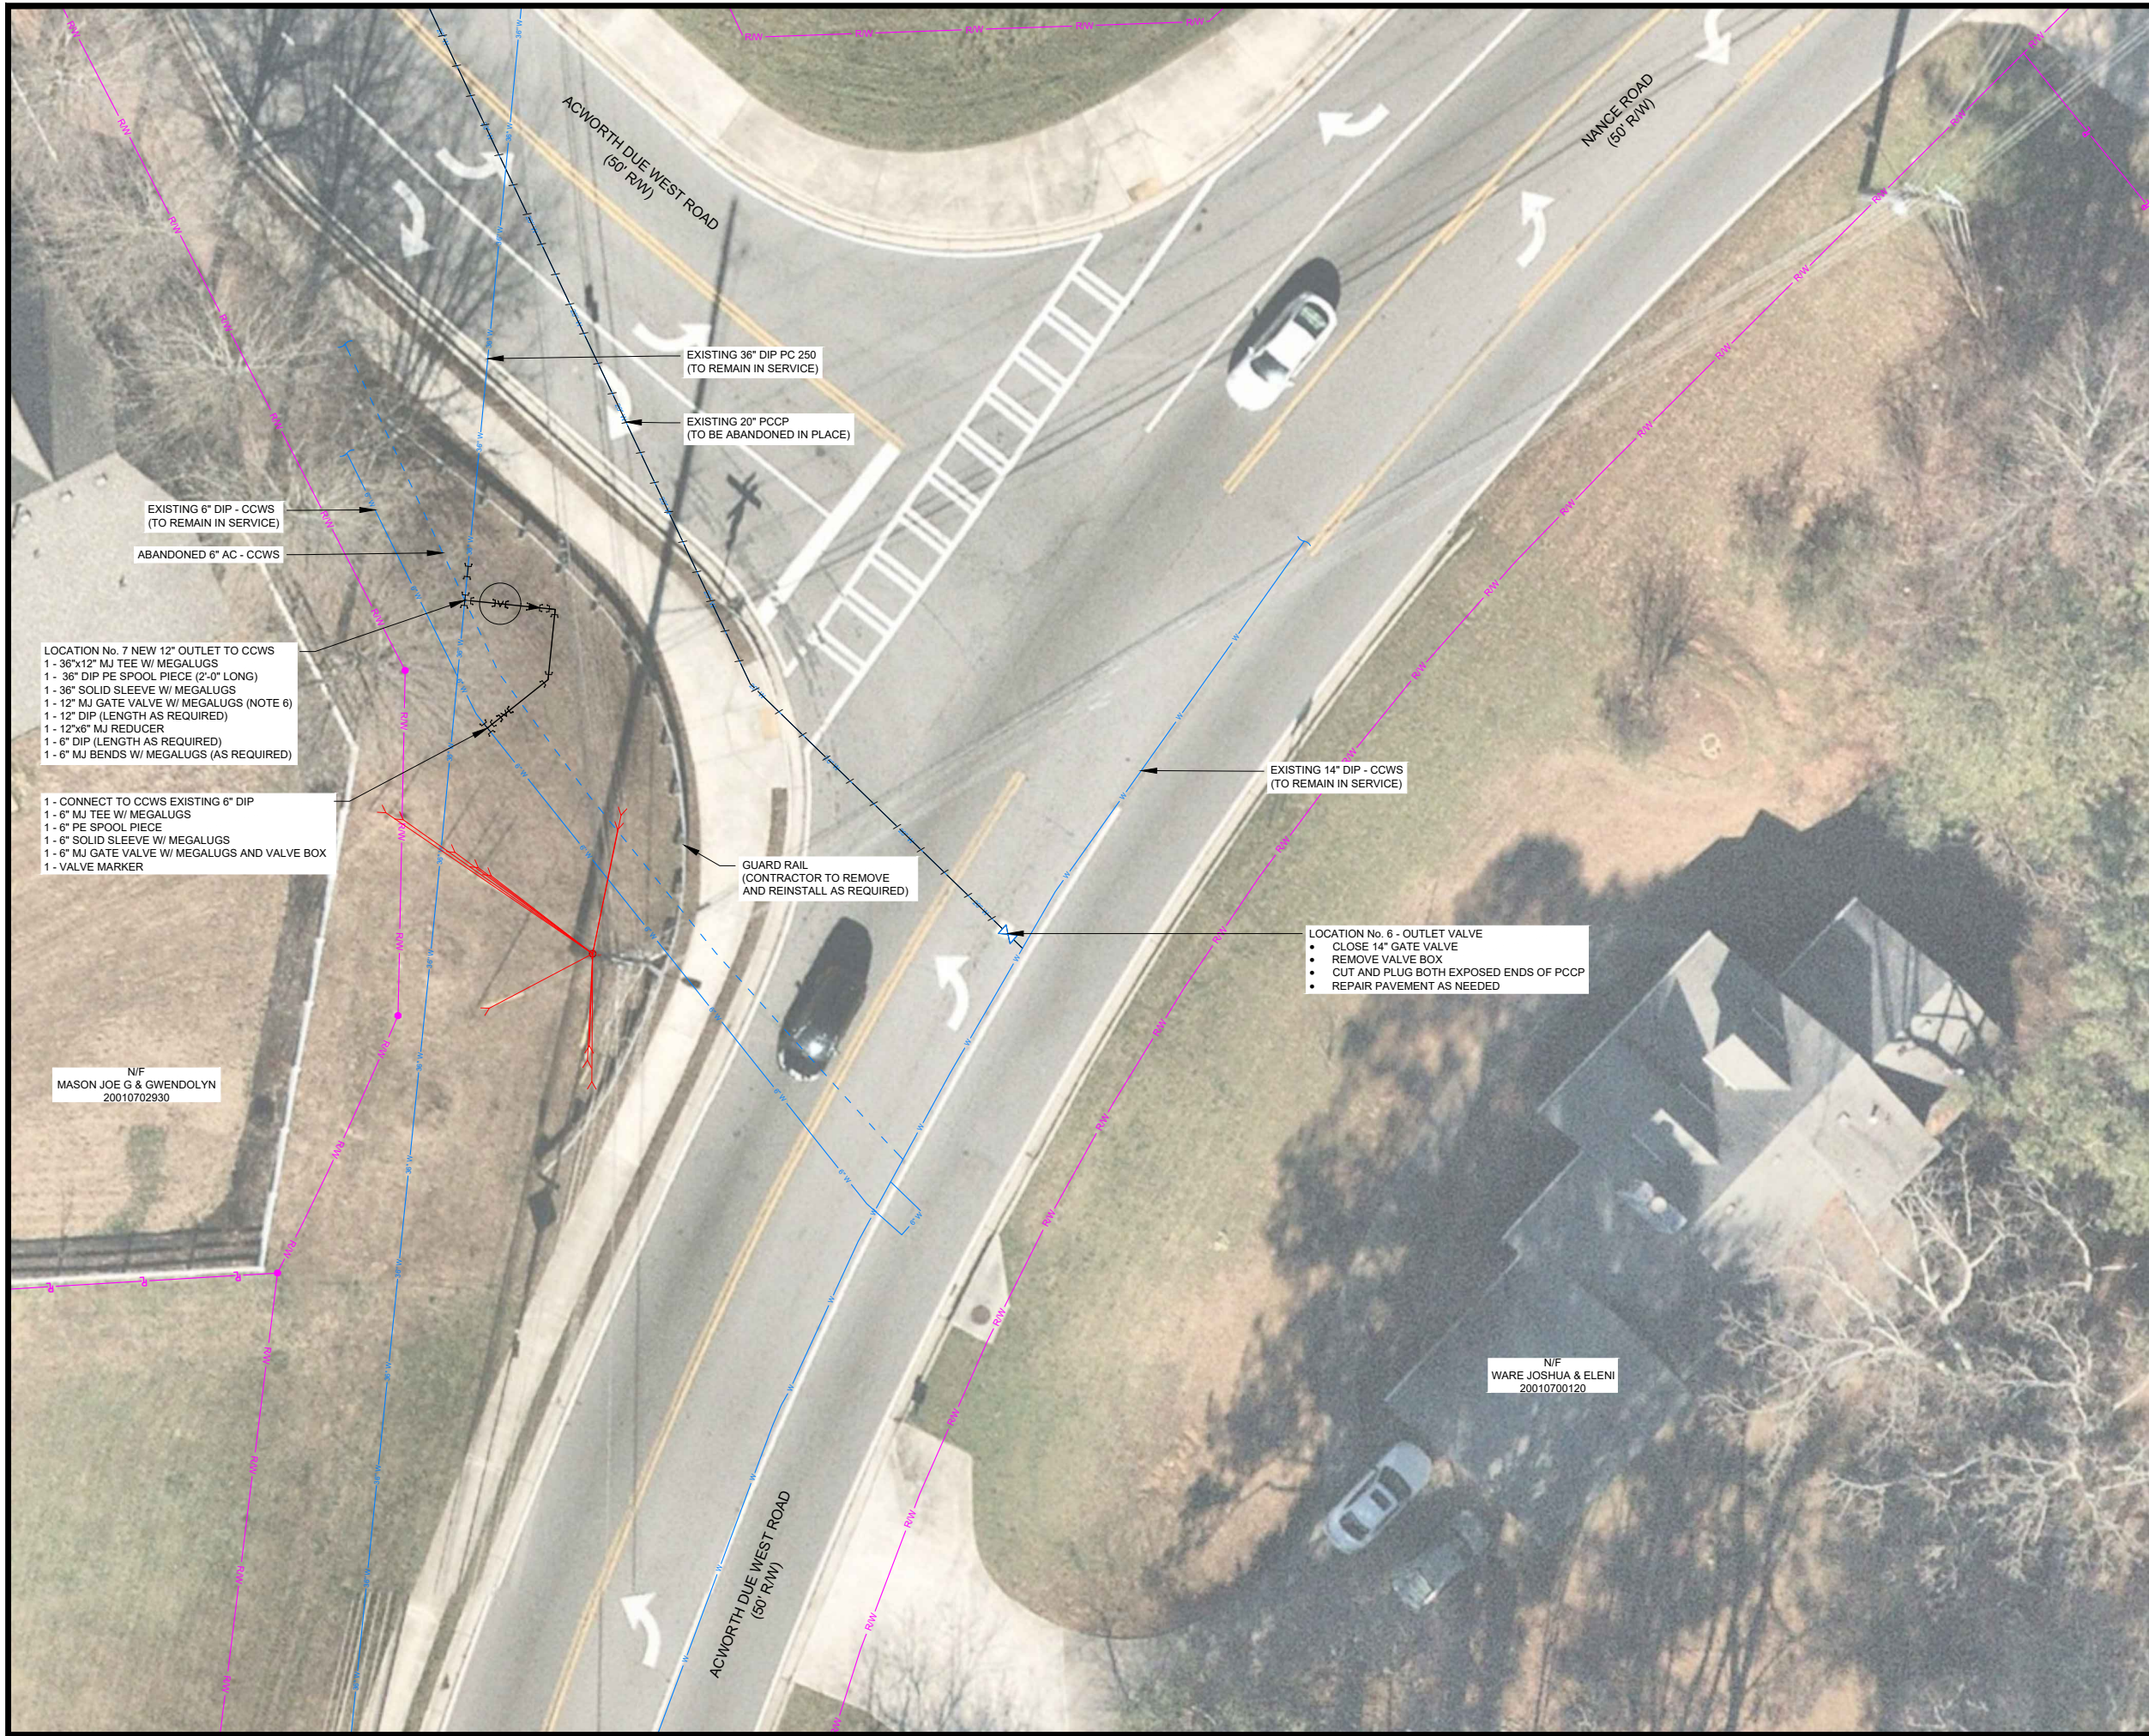

- NOTES:
1. ALL NEW PIPE/FITTINGS ARE ZINC COATED AND DOUBLE POLY-WRAPPED WITH BLACK 8-MIL OUTER LAYER AND WHITE 4-MIL V-BIO INNER LAYER.
 2. ALL NEW PIPE/FITTINGS SHALL BE INSTALLED USING TYPE 5 BEDDING.
 3. NEW CONNECTION BETWEEN CCMWA 36" DIP AND CCWS 6" DIP ARE SHOWN CONCEPTUALLY. CONTRACTOR SHALL ADJUST THE LAYOUT AS REQUIRED PER FIELD CONDITIONS.
 4. CONTRACTOR IS RESPONSIBLE FOR COORDINATING WITH COBB EMC SHOULD THE POWER POLE GUY WIRES NEED TO BE TEMPORARILY REMOVED OR SUPPORTED FOR CONSTRUCTION OF PROPOSED WATER MAIN CONNECTIONS.
 5. SHOULD THE ABANDONED 6" AC PIPE BE ENCOUNTERED DURING CONSTRUCTION, THE CONTRACTOR SHALL MAKE EVER EFFORT NOT TO BREAK THE PIPE AND SHALL REMOVE AND DISPOSE OF IT IN A LEGAL AND PROPER MANNER.
 6. 12" GATE VALVE SHALL BE INSTALLED IN 4' Ø MANHOLE WITH A FLAT TOP AND A 30" FRAME AND COVER. RIM SHALL BE FLUSH WITH EXISTING GRADE.

- LOCATION No. 7 NEW 12" OUTLET TO CCWS
- 1 - 36"x12" MJ TEE W/ MEGALUGS
 - 1 - 36" DIP PE SPOOL PIECE (2'-0" LONG)
 - 1 - 36" SOLID SLEEVE W/ MEGALUGS
 - 1 - 12" MJ GATE VALVE W/ MEGALUGS (NOTE 6)
 - 1 - 12" DIP (LENGTH AS REQUIRED)
 - 1 - 12"x6" MJ REDUCER
 - 1 - 6" DIP (LENGTH AS REQUIRED)
 - 1 - 6" MJ BENDS W/ MEGALUGS (AS REQUIRED)

- 1 - CONNECT TO CCWS EXISTING 6" DIP
- 1 - 6" MJ TEE W/ MEGALUGS
- 1 - 6" PE SPOOL PIECE
- 1 - 6" SOLID SLEEVE W/ MEGALUGS
- 1 - 6" MJ GATE VALVE W/ MEGALUGS AND VALVE BOX
- 1 - VALVE MARKER

- LOCATION No. 6 - OUTLET VALVE
- CLOSE 14" GATE VALVE
 - REMOVE VALVE BOX
 - CUT AND PLUG BOTH EXPOSED ENDS OF PCCP
 - REPAIR PAVEMENT AS NEEDED

N/F
MASON JOE G & GWENDOLYN
20010702930

N/F
WARE JOSHUA & ELENI
20010700120

PROJECT NUMBER: 505-9005-38-20-0000
 PROJECT DATE: OCTOBER 2020

REVISION	DATE

DESIGNED BY: DE	DE
DRAWN BY: DE	DE
REVIEWED BY: JRF	JRF

BAR BELOW IS 1" LONG FOR SCALE. IF NOT PLONG ON THIS SHEET, ADJUST SCALES ACCORDINGLY.


COBB COUNTY-MARIETTA WATER AUTHORITY
 2021 BLOW-OFF REPLACEMENTS

LOCATIONS 7 AND 8


4

L:\CCMWA\2021 Blow-off Replacements\Drawings\Locations.dwg - 10/20/2020 8:53 AM BY: JFLECK


- NOTES:
- 90° BEND USED ONLY WHERE EXISTING UTILITIES OR SPACE DOES NOT ALLOW PIPING STRAIGHT OUT FROM 48" OR 36" TEE.
 - ALL NEW PIPE/FITTINGS ARE ZINC COATED AND DOUBLE POLY-WRAPPED WITH BLACK 8-MIL OUTER LAYER AND WHITE 4-MIL V-BIO INNER LAYER.

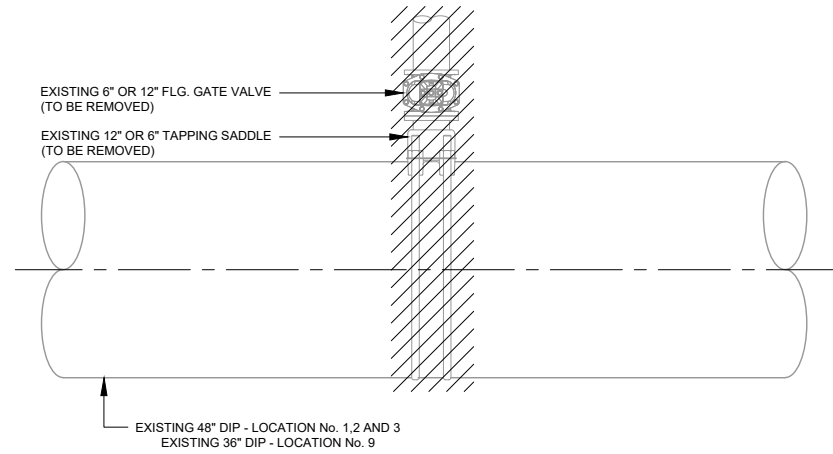

EXISTING LAYOUT - LOCATION Nos. 1, 2, 3 AND 8

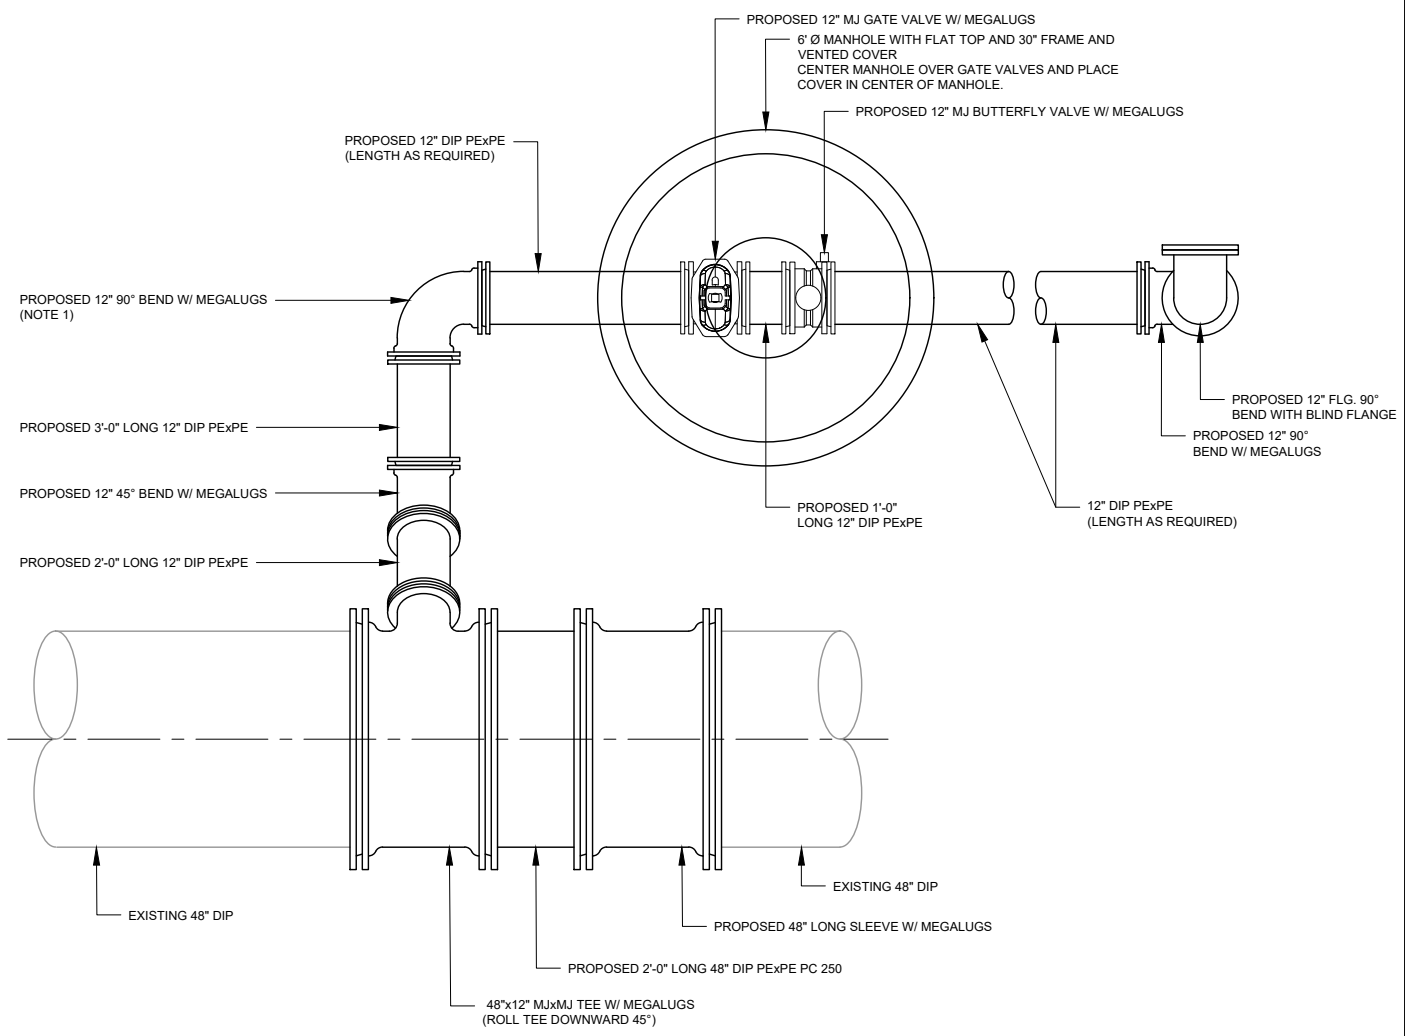

LOCATIONS 1 AND 2

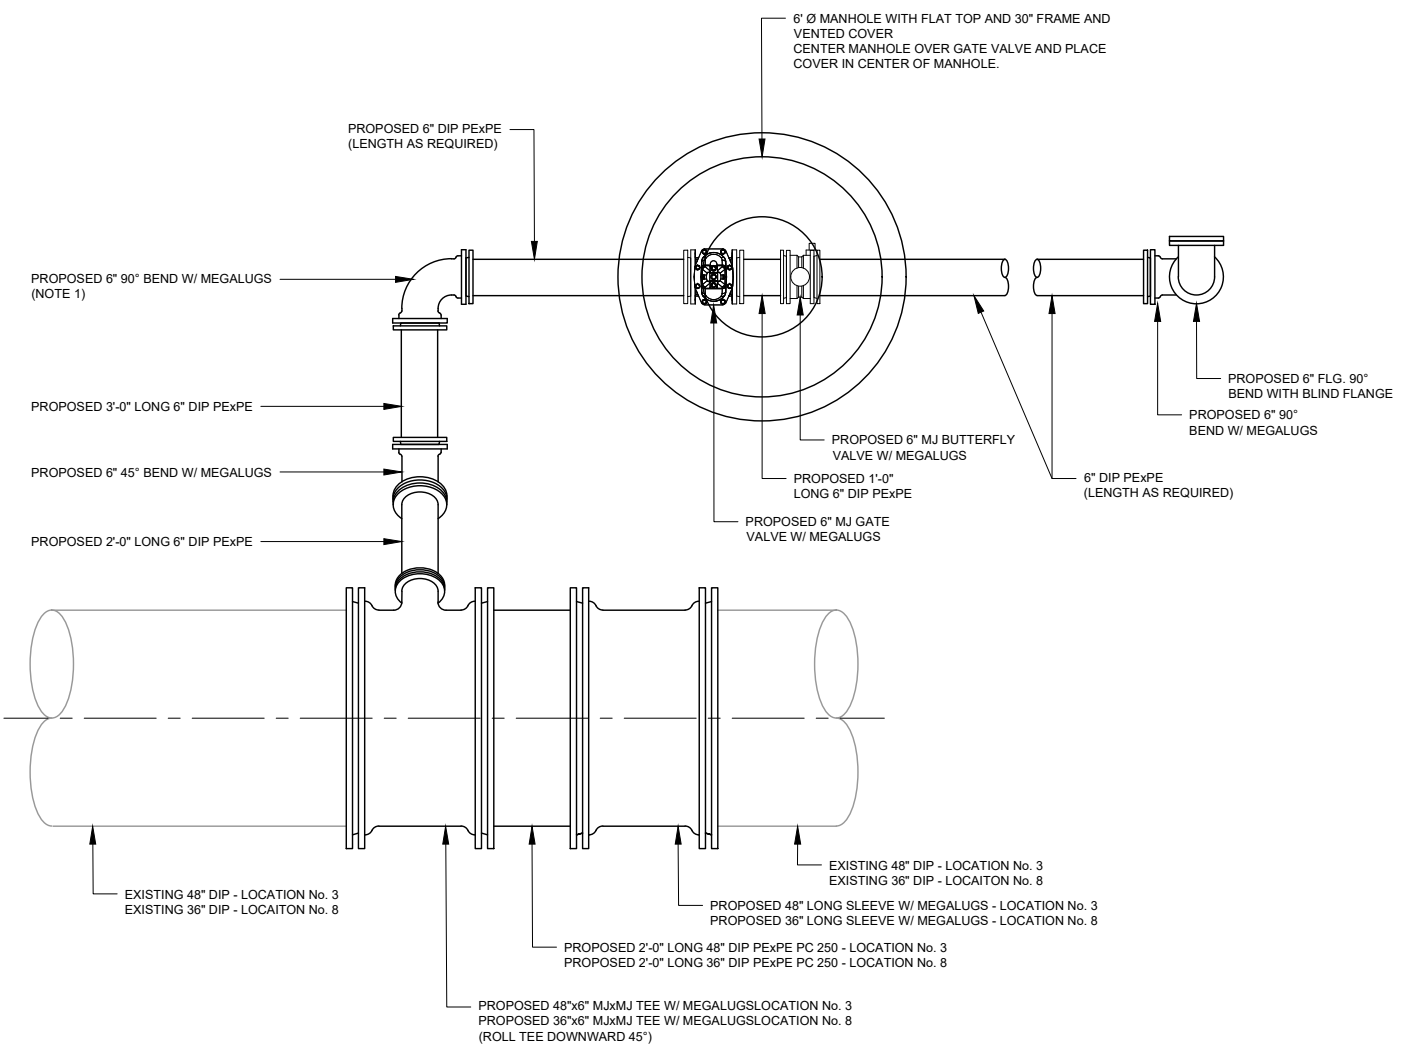

LOCATIONS 3 AND 8

BLOW-OFF REPLACEMENT DETAIL 1

SCALE: 1/2" = 1'-0"







PROJECT NUMBER: 505-9005-35-20-0000
 PROJECT DATE: OCTOBER 2020

DESIGNED BY:
 DRAWN BY:
 REVIEWED BY:

DATE
 REVISION

COBB COUNTY-MARIETTA WATER AUTHORITY
 2021 BLOW-OFF REPLACEMENTS

BLOW-OFF REPLACEMENT DETAIL

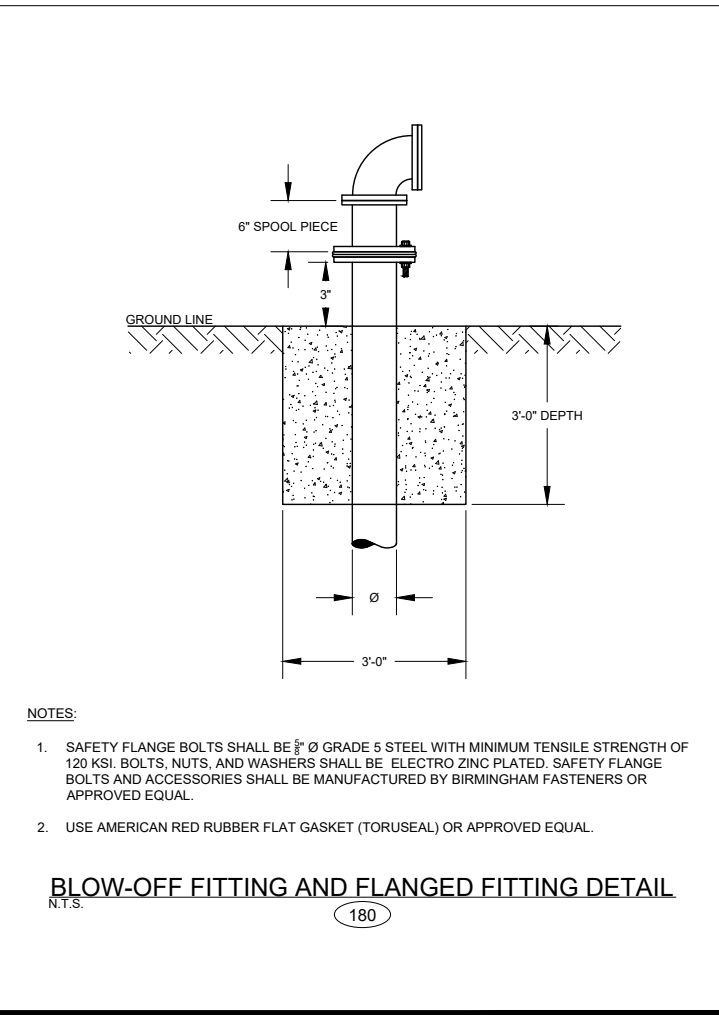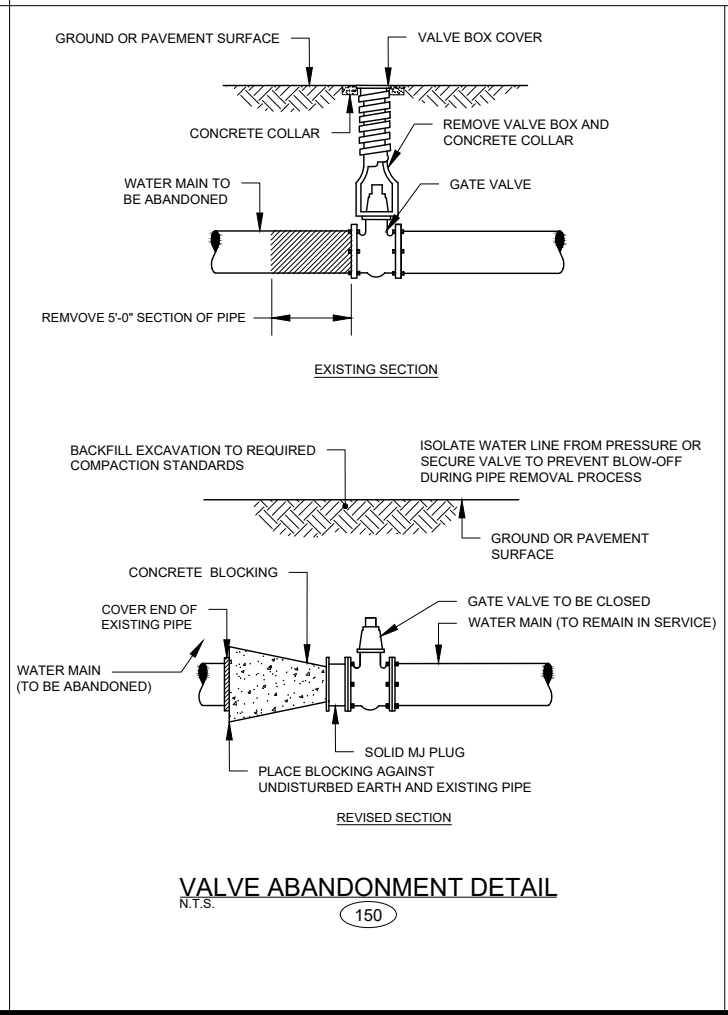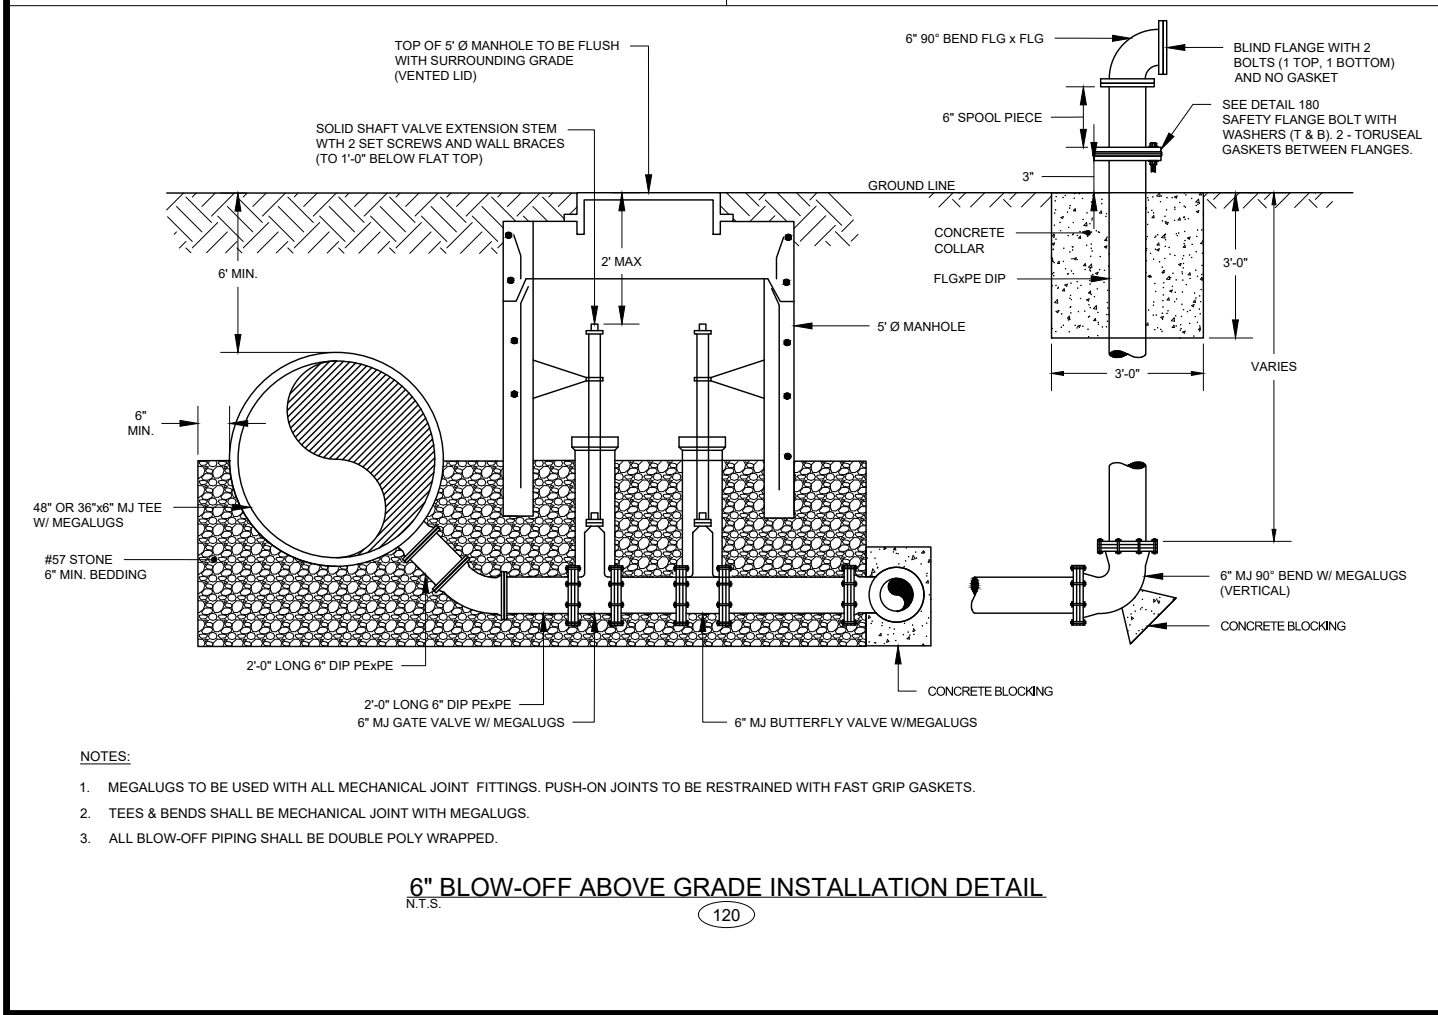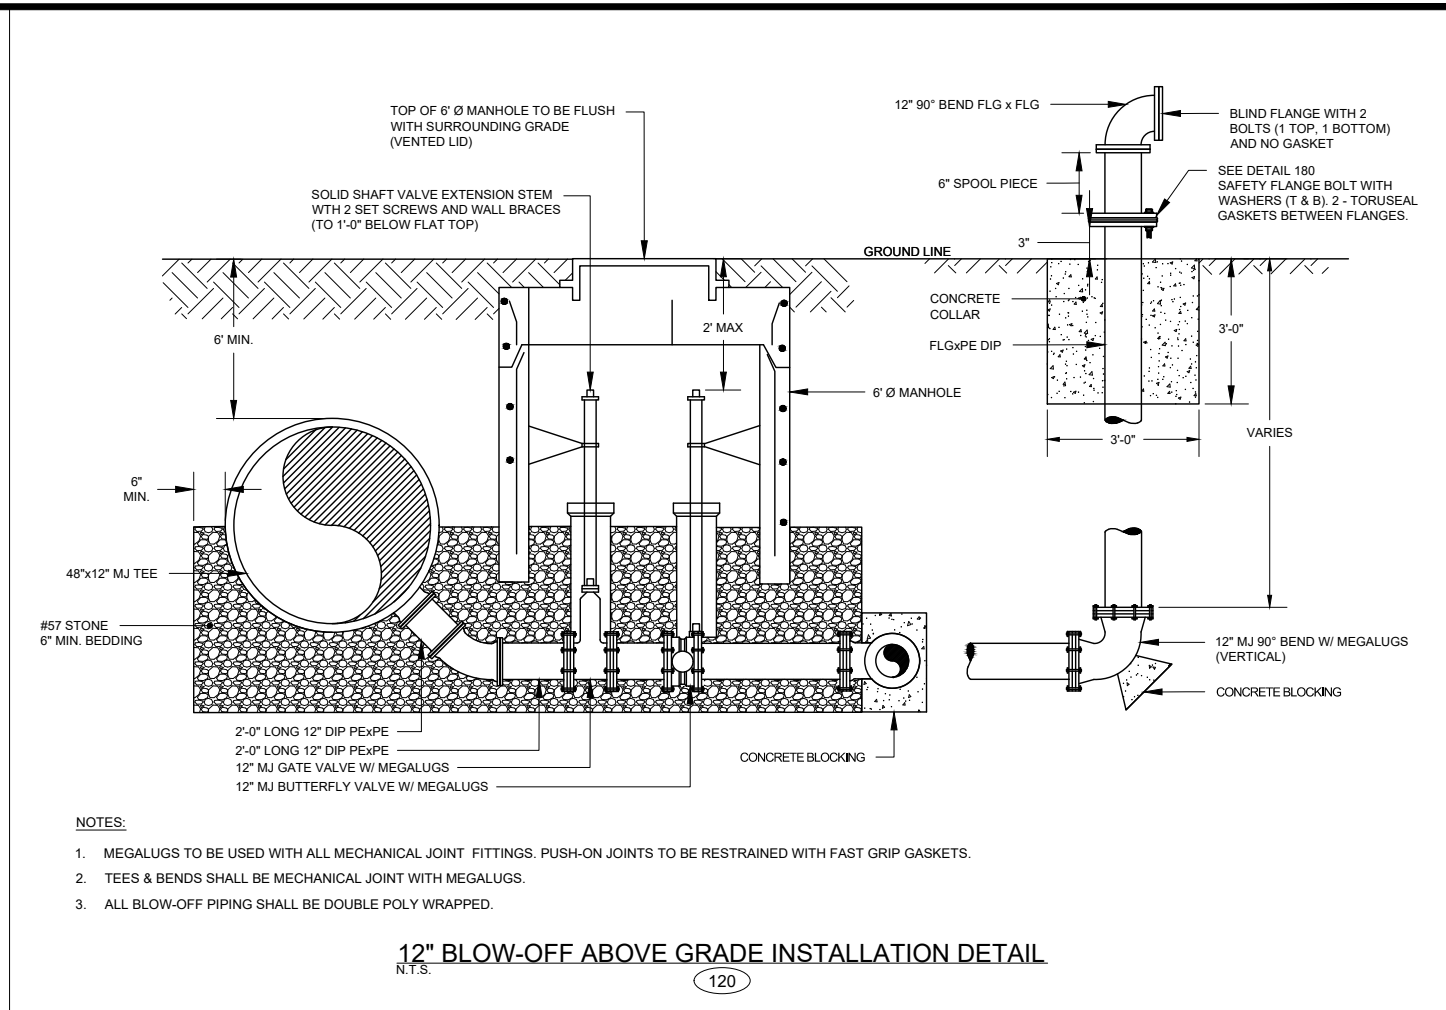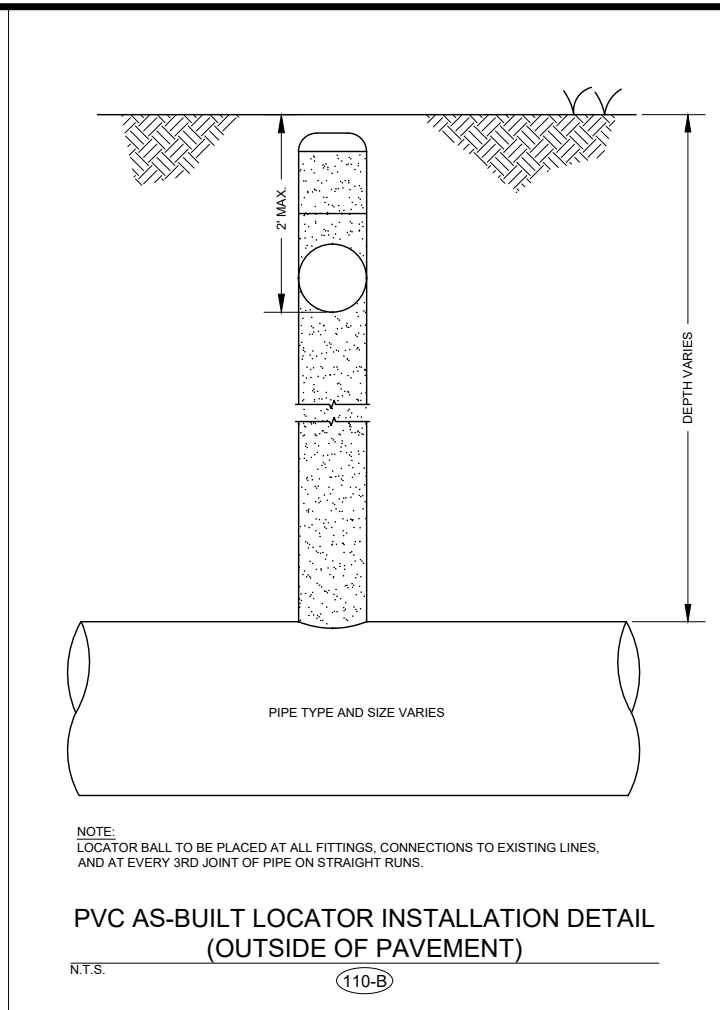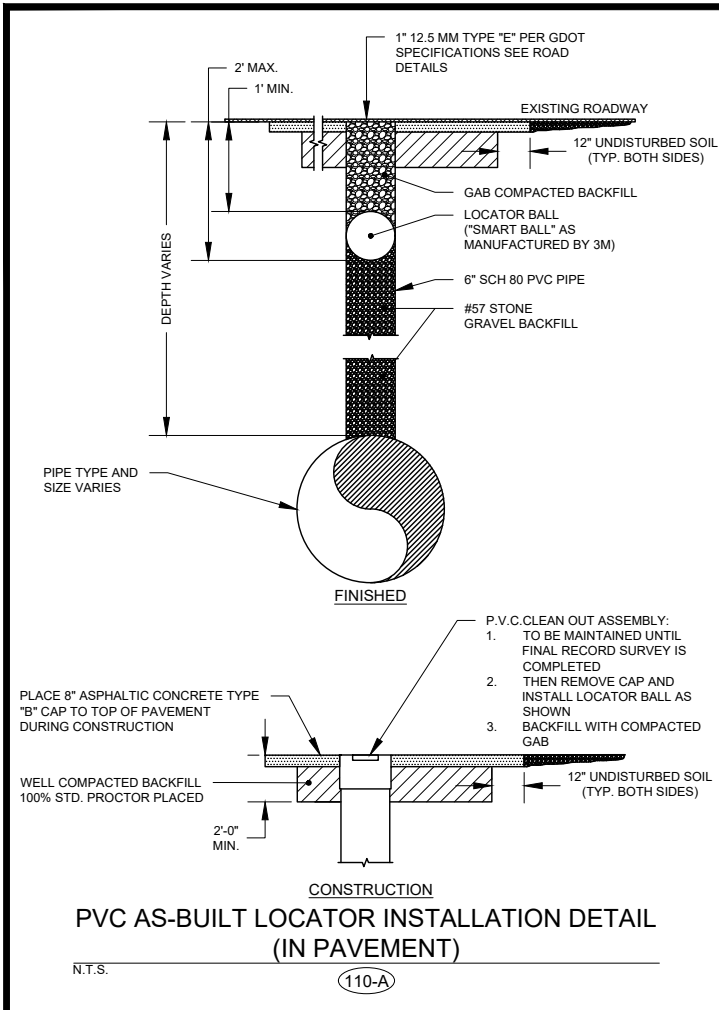

ESI
ENGINEERING STRATEGIES, INC.

PROJECT NUMBER: 505-9005-39-20-0000
PROJECT DATE: OCTOBER 2020


DATE	REVISION

DESIGNED BY: DE
DRAWN BY: DE
REVIEWED BY: JRF

BAR BELOW IS 1" LONG FOR SCALE. IF NOT PLONG ON THIS SHEET, ADJUST SCALES ACCORDINGLY.

COBB COUNTY-MARIETTA WATER AUTHORITY
2021 BLOW-OFF REPLACEMENTS
STANDARD DETAILS (1 OF 4)

6

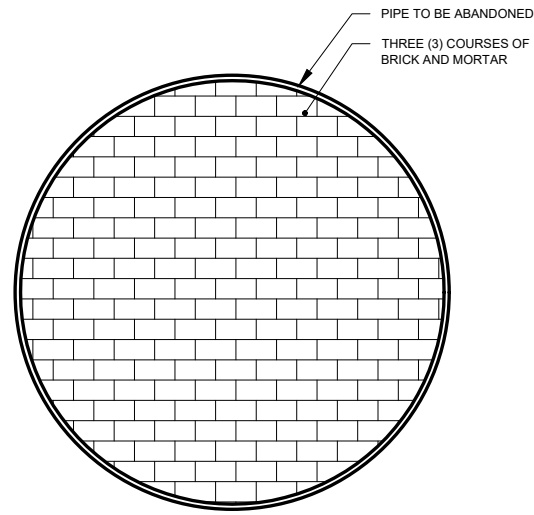

ABANDONED PIPE AND BULKHEAD BRICK DETAIL
N.T.S.

230


"J" Ø GATE VALVE	"X" Ø MANHOLE DIAMETER
20"	8'
24"	8'
36"	8'
42"	10'
48"	10'

- "J" Ø GATE VALVE
- 4" BLIND FLANGE TAPPED AND THREADED FOR 2" CORP STOP (NOTE 1)
- 4" FLANGED, GATE VALVE WITH HANDWHEEL OPERATOR (NOTE 1)
- 4" FLANGED, WELDED-ON OUTLET (NOTE 1)
- DOGHOUSE MANHOLE CUT-OUT. MINIMUM 6" CLEARANCE ALL SIDES OF PIPE
- BOTTOM OF MANHOLE TO BE AT OR BELOW BOTTOM OF PIPE

GATE VALVE TEST STATION PIPING ARRANGEMENT DETAILS
N.T.S.

240


- NOTES:
- THE 4" FLANGED WELDED-ON OUTLET, 4" GATE VALVE, 4" BLIND FLANGE AND 2" CORP STOP SHOWN SHALL BE INSTALLED ON BOTH SIDES OF THE LINE VALVE.
 - THIS DETAIL TO BE USED FOR CLARITY AND WORKMANSHIP IN THE INSTALLATION OF 2" TEST STATION PIPING.
 - STONE BACKFILL INSIDE MANHOLE TO BE JUST BELOW THE CROWN OF THE PIPE SUCH THAT THE WELD-ON OUTLET IS FULLY EXPOSED AND VISIBLE.
 - FULLY EXTEND RESTRAINED JOINTS BEFORE INSTALLATION OF 2" COPPER PIPE.

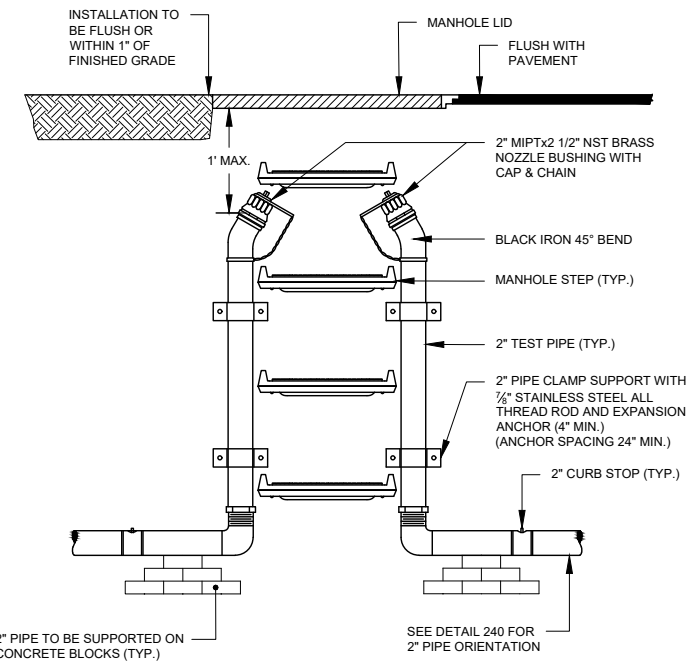

- NOTE:
- INSULATE BETWEEN DISSIMILAR METALS WITH RUBBER GASKET MATERIAL.
 - ALL 2" PIPE, FITTINGS AND HARDWARE SHALL BE RATED FOR WORKING PRESSURE OF MINIMUM 250 PSI.


IN-LINE VALVE MANHOLE AND TEST CONNECTIONS DETAIL
N.T.S.

240-A

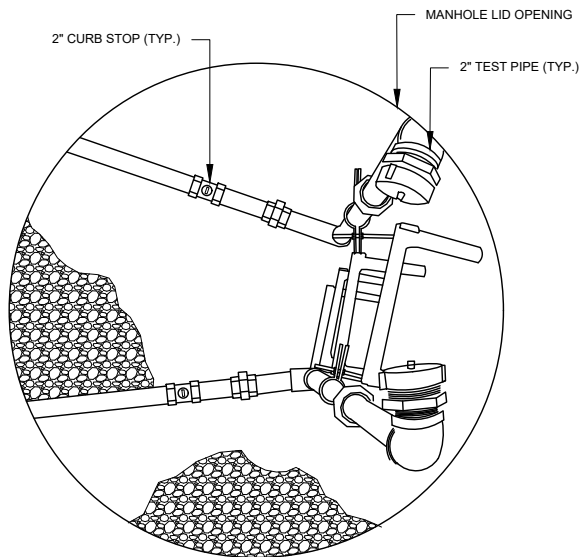

VALVE TEST CONNECTIONS DETAIL
N.T.S.

240-B

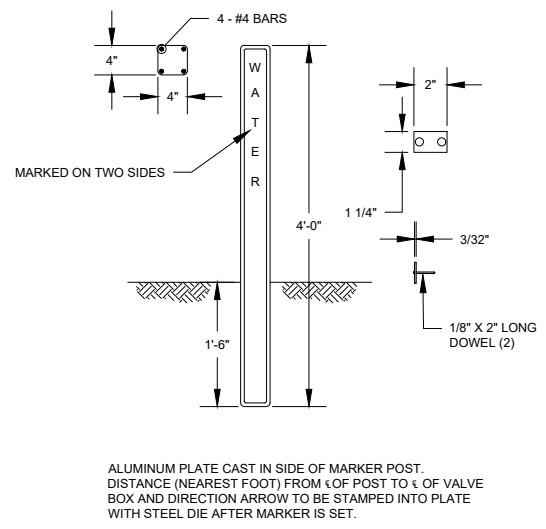

VALVE MARKER DETAIL
N.T.S.

310


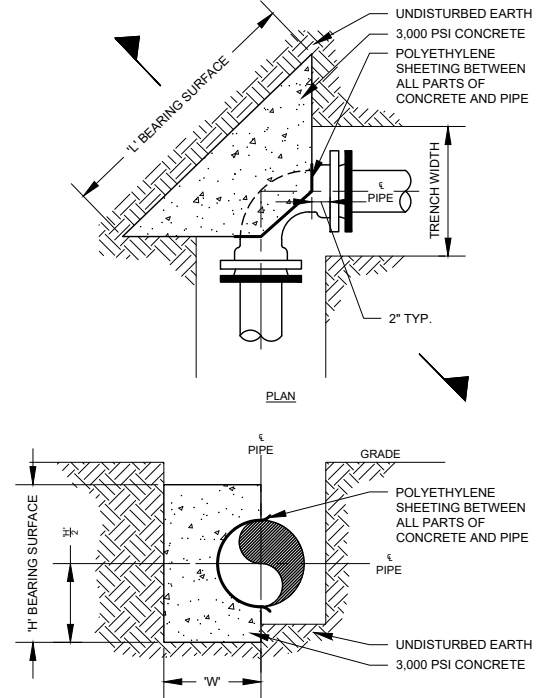


TABLE FOR CONCRETE BLOCKING (225 PSI TEST PRESSURE)	
MINIMUM BEARING AREA (LENGTH x HEIGHT)	
FITTING	6" Ø 8" Ø 10" Ø 12" Ø 16" Ø
11 1/2" BEND	1 x 1 2 x 1 2 x 1 2 x 2 3 x 2
22 1/2" BEND	2 x 1 2 x 2 2 x 2 3 x 2 4 x 3
45° BEND	2 x 2 2 x 2 3 x 2 4 x 2 5 x 3
90° BEND	3 x 2 4 x 2 4 x 4 5 x 3 6 x 5
TEE	2 x 2 3 x 2 4 x 2 4 x 3 6 x 3
DEAD END	2 x 2 3 x 2 4 x 2 4 x 3 6 x 3

CONCRETE BLOCKING DETAIL
N.T.S.

320

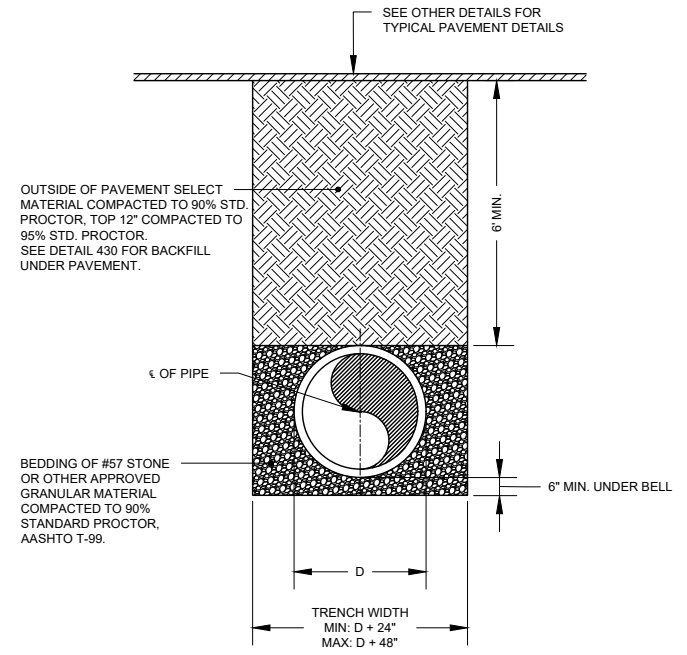

- NOTES:
- TYPE 5 BEDDING SHALL BE USED FOR THE ENTIRE LENGTH OF THIS PROJECT.
 - PLACE EARTHEN DAM EVERY 200' OF PIPE.

TYPE 5 (MODIFIED) BEDDING DETAIL
N.T.S.


330

DESIGNED BY: DE
DRAWN BY: DE
REVIEWED BY: JRF
PROJECT NUMBER: 505-9005-39-20-0000
PROJECT DATE: OCTOBER 2020

BAR BELOW IS 1" LONG FOR SCALE. IF NOT PLACED ON THIS SHEET, ADJUST SCALES ACCORDINGLY.


COBB COUNTY-MARIETTA WATER AUTHORITY
2021 BLOW-OFF REPLACEMENTS
STANDARD DETAILS (2 OF 4)

ESI
ENGINEERING STRATEGIES, INC.

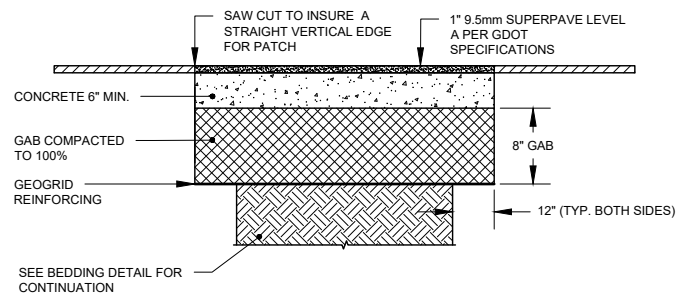


- NOTES:
1. ALL PAVEMENT TO BE SAW CUT
 2. SURFACES TO BE CLEANED AND BITUMINOUS TACK COAT PRIME APPLIED BEFORE PLACEMENT OF ASPHALTIC TOP.


ASPHALT REPAIR DETAIL
N.T.S. (340)

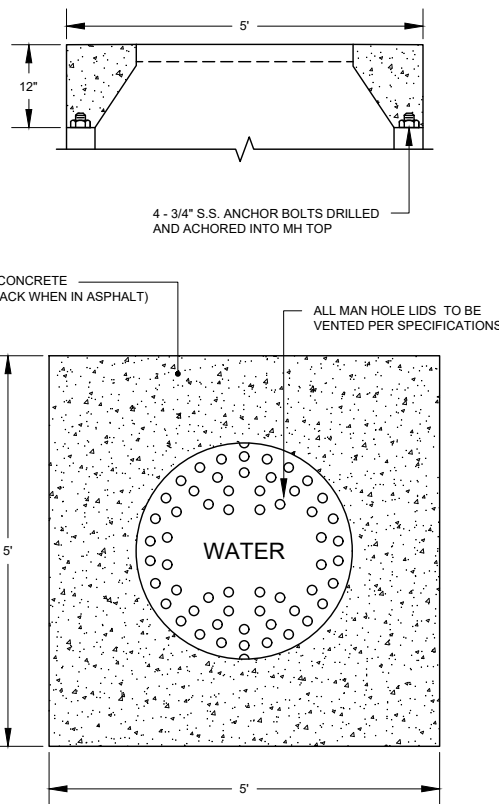

MANHOLE LID & CONCRETE PAD DETAIL #1
N.T.S. (450)

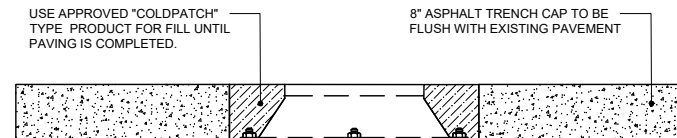


DETAIL FOR TEMPORARY - DURNING CONSTRUCTION

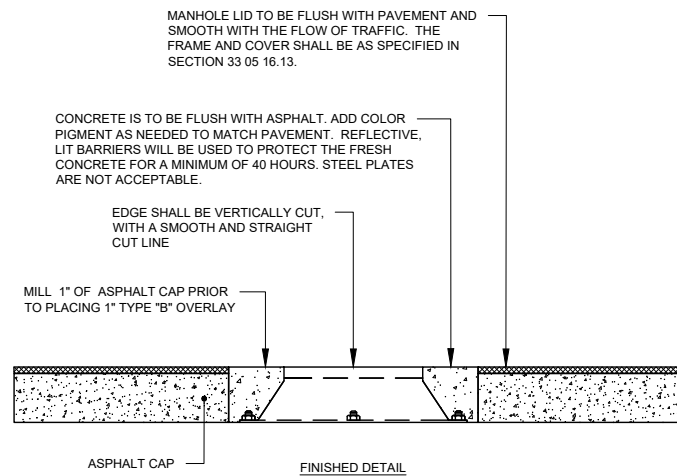

NOTE: ALL MAN HOLE LIDS TO BE VENTED PER SPECIFICATIONS.


MANHOLE LID & CONCRETE PAD DETAIL #2 DETAIL
N.T.S. (460)

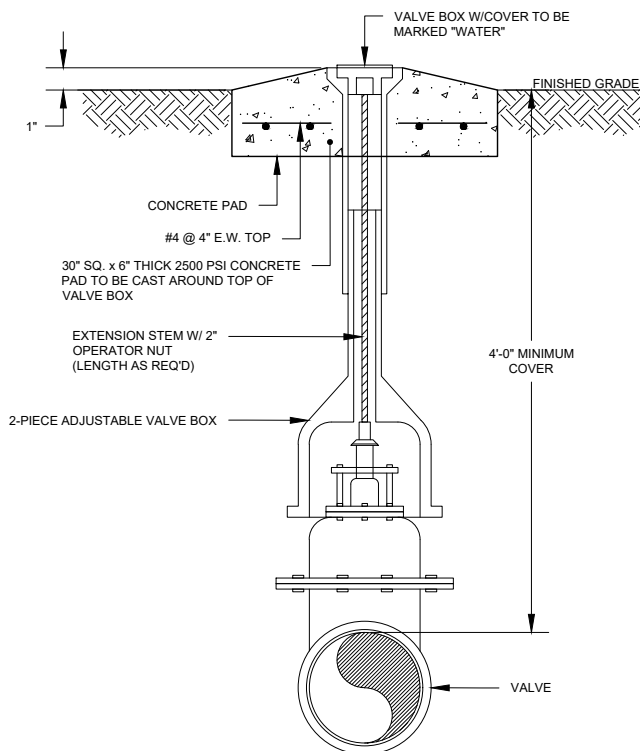


NOTES:

1. CAST AROUND THE TOP OF EACH VALVE BOX A CONCRETE PAD 2'-0" IN DIA. OR 2'-0" SQUARE AND 8" THICK WHEN VALVES ARE LOCATED IN UNPAVED AREAS. PAD NOT REQUIRED IN PAVED AREAS.
2. IF PRECAST PADS ARE USED, THE VOID BETWEEN THE PRECAST PAD AND THE VALVE BOX SHALL BE FILLED W/ NON-SHRINK EPOXY GROUT.


TYPICAL VALVE BOX AND OPERATOR SETTING DETAIL
N.T.S.

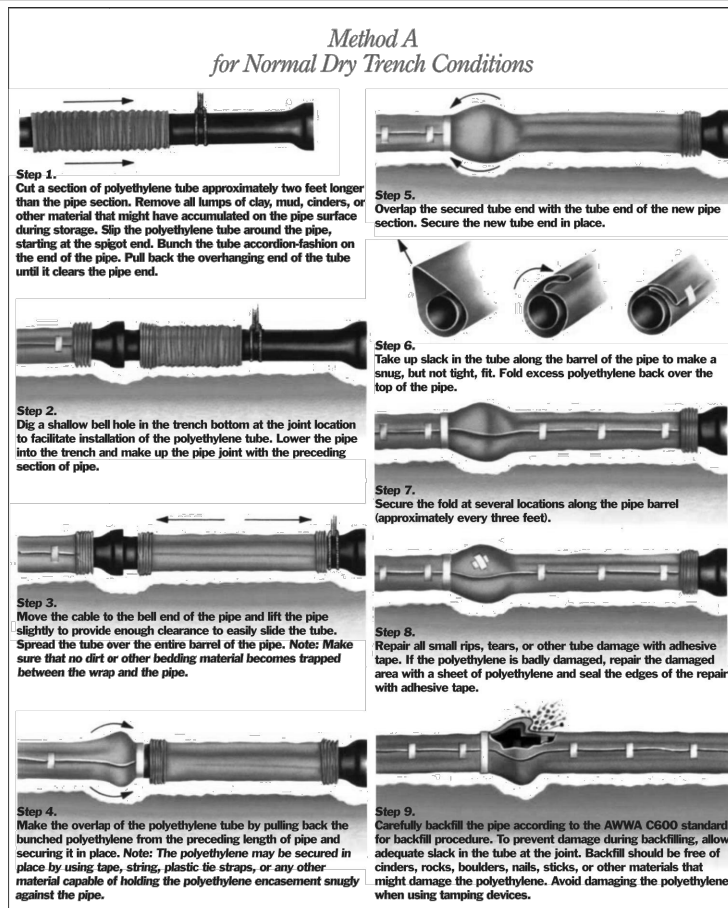

POLYETHYLENE ENCASEMENT INSTALLATION DETAIL
N.T.S.

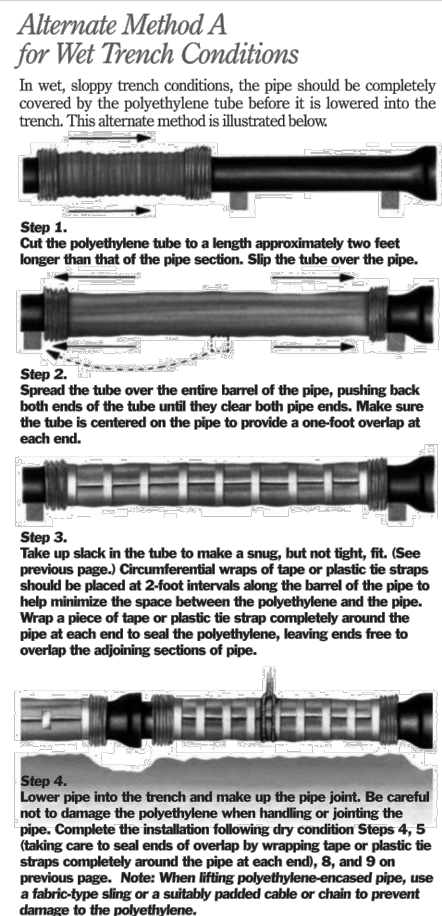


ALTERNATE METHOD A FOR WET TRENCH CONDITIONS
N.T.S.

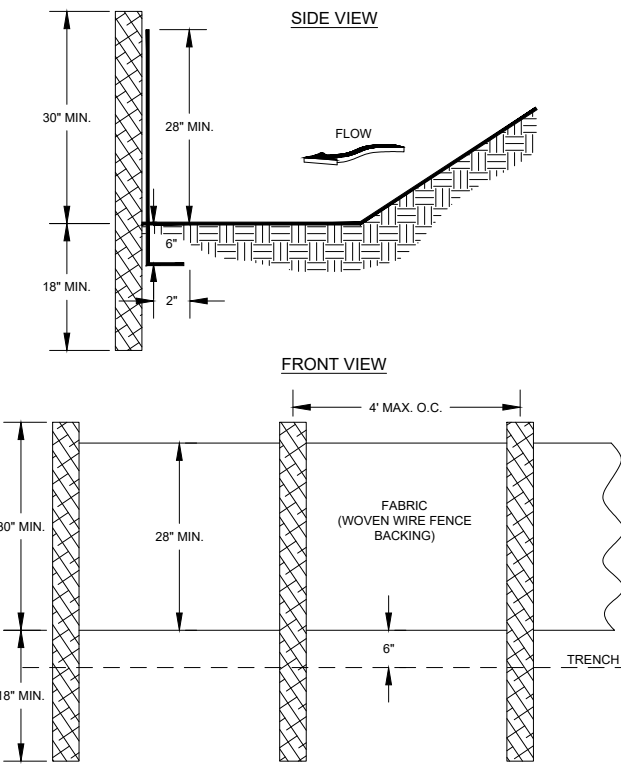

- NOTES:
1. USE STEEL POSTS AS SPECIFIED BY THE EROSION, SEDIMENTATION, AND POLLUTION CONTROL PLAN.

SILT FENCE - TYPE SENSITIVE
N.T.S. (Sd1-S)

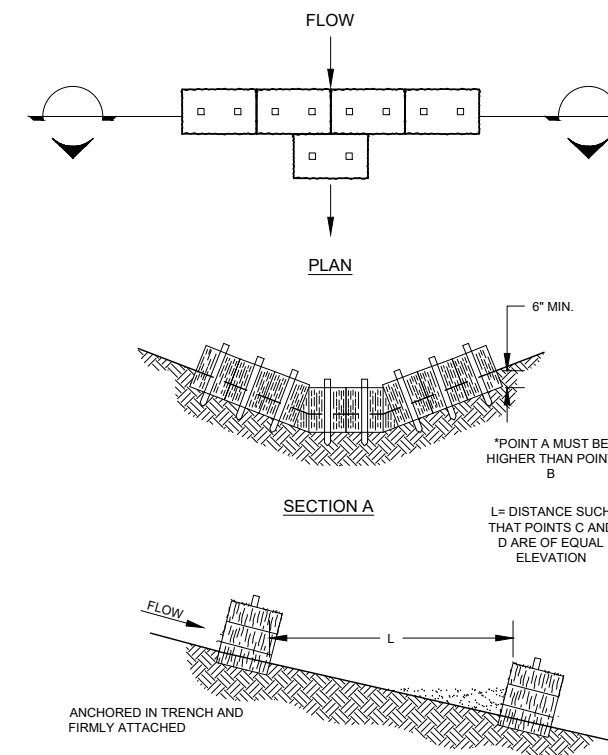

CHANNEL PROFILE - SPACING BETWEEN EROSION BALES

HAYBALE CHECK DAM
N.T.S. (Cd)

ESI
ENGINEERING STRATEGIES, INC.


PROJECT NUMBER: 505-9005-38-20-0000
PROJECT DATE: OCTOBER 2020

REVISION	DATE

DESIGNED BY: DE
DRAWN BY: DE
REVIEWED BY: JRF

SCALE: 1" = 10'-0" LONG FOR SECTION A
SCALE: 1" = 10'-0" LONG FOR SECTION B
ADJUST SCALES ACCORDINGLY

COBB COUNTY-MARIETTA WATER AUTHORITY
2021 BLOW-OFF REPLACEMENTS
STANDARD DETAILS (3 OF 4)

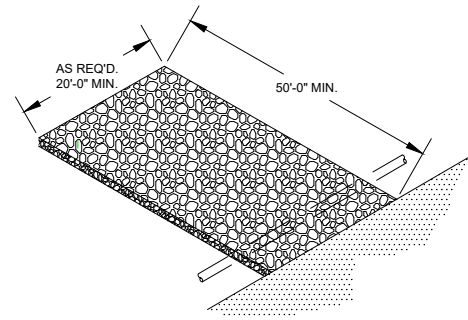

NOTE:
EXIT SHALL BE MAINTAINED IN A CONDITION WHICH WILL PREVENT TRACKING OR FLOW OF MUD ONTO PUBLIC R.O.W. THIS MAY REQUIRE PERIODIC TOP DRESSING WITH 1.5 TO 3.5 INCH STONE, AS CONDITIONS DEMAND, AND REPAIR AND/OR CLEANOUT OF ANY STRUCTURES USED TO TRAP SEDIMENT. ALL MATERIALS SPILLED, DROPPED, WASHED, OR TRACKED FROM VEHICLES OR SITE ONTO ROADWAYS OR INTO STORM DRAINS MUST BE REMOVED IMMEDIATELY.

TEMPORARY CONSTRUCTION EXIT
N.T.S. (Co)


NOTES:

PURPOSE


OPEN CHANNELS ARE CONSTRUCTED OR STABILIZED TO BE NON-EROSIVE, WITH NO SEDIMENT DEPOSITION AND TO PROVIDE ADEQUATE CAPACITY FOR FLOOD WATER, DRAINAGE, OTHER WATER MANAGEMENT PRACTICES, OR ANY COMBINATION THEREOF.

INSTALLATION

1. INSTALL IN ACCORDANCE WITH THE "MANUAL FOR EROSION AND SEDIMENT CONTROL IN GEORGIA" (RIP-RAP APPENDIX C), AS SHOWN ON THE PLANS, AND AS DIRECTED BY THE ENGINEER.
2. DUMPED AND MACHINE PLACED RIP-RAP SHOULD NOT BE INSTALLED ON SLOPES STEEPER THAN 1.5:1.
3. ROCK SHALL BE DENSE, RESISTANT TO THE ACTION OF AIR AND WATER, AND SUITABLE IN ALL OTHER RESPECTS FOR THE PURPOSE INTENDED.
4. THE GEOTEXTILE SHALL BE PLACED ON A SMOOTH GRADED SURFACE AND IN SUCH A MANNER THAT IT WILL NOT EXCESSIVELY STRETCH OR TEAR UPON PLACEMENT OF THE OVERLYING MATERIALS. CARE SHOULD BE TAKEN TO PLACE THE GEOTEXTILE IN INTIMATE CONTACT WITH THE SOIL SUCH THAT NO VOID SPACES EXIST BETWEEN THE UNDERLYING SOIL AND THE GEOTEXTILE.

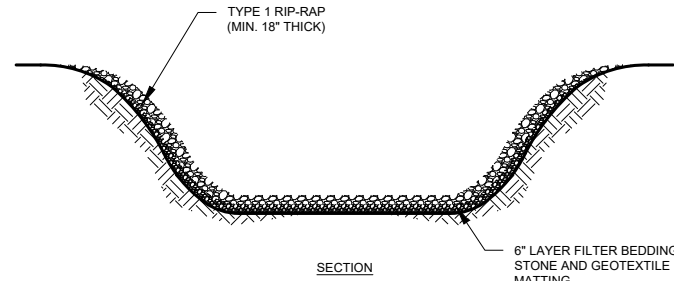


CHANNEL STABILIZATION
N.T.S. (Ch-Rp)

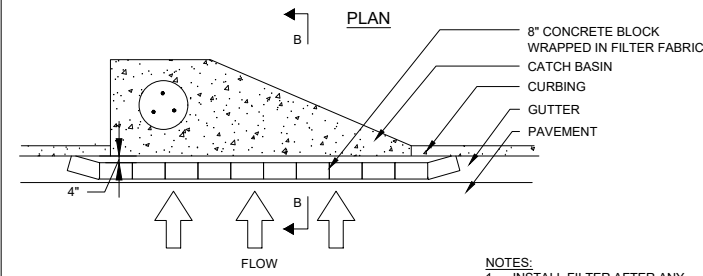

NOTES:

1. INSTALL FILTER AFTER ANY ASPHALT PAVEMENT INSTALLATION.
2. WRAP 8" CONCRETE BLOCKS IN FILTER FABRIC AND SPAN ACROSS CATCH BASIN INLET.
3. FACE OPENINGS IN BLOCKS OUTWARD.
4. LEAVE A GAP OF APPROXIMATELY 4 INCHES BETWEEN THE CURB AND THE FILTERS TO ALLOW FOR OVERFLOW TO PREVENT HAZARDOUS PONDING.
5. INSTALL OUTLET PROTECTION BELOW STORM DRAIN OUTLETS.

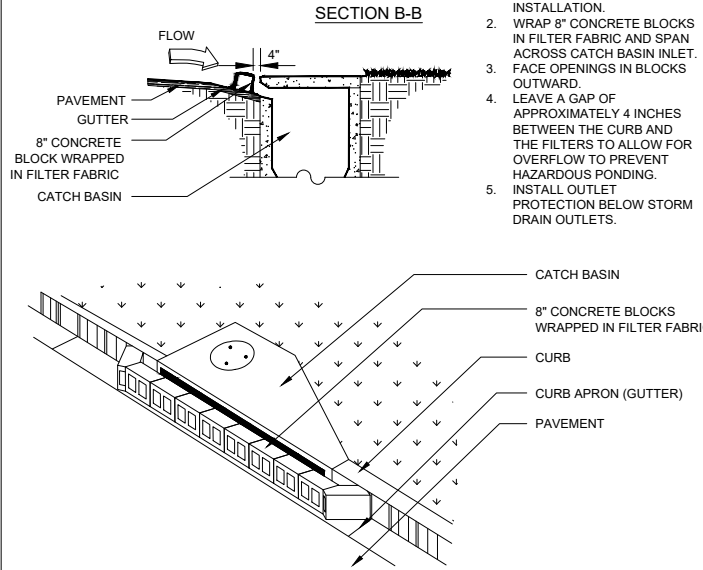

CURB INLET FILTER "PIGS IN A BLANET"
N.T.S. (Sd2-P)

PROJECT NUMBER: 505-9005-39-20-0000
PROJECT DATE: OCTOBER 2020

REVISION	DATE

DESIGNED BY:
DRAWN BY:
REVIEWED BY:

BAR BELOW IS 1" LONG FOR EACH FOOT OF LENGTH. IF NOT 1" LONG ON THIS SHEET, ADJUST SCALES ACCORDINGLY.



COBB COUNTY-MARIETTA WATER AUTHORITY
2021 BLOW-OFF REPLACEMENTS

STANDARD DETAILS (4 OF 4)